

MISSISSIPPI DEPARTMENT OF NATURAL RESOURCES

Bureau of Land and Water Resources

Southport Mall

P.O. Box 10631

Jackson, Mississippi 39209

WATER WELL DRILLERS LOG

Jackson  
H  
H 2105

H

8/29

1989

Stinger + Son

Jackson

date well completed

firm name

county well located

LANDOWNER: Mrs Kelly White

description of formations encountered

from to

Top Soil

0' 2'

Clay

3' 25'

Sand

25' 20'

(mailing address)

WELL LOCATION:

sec. 33 T. 6 N. R. 57 E

(distance) miles (direction) of (nearest town)

WELL PURPOSE:

(home, irrigation, municipal, industrial)

WELL COMPLETION DATA:

- (1) diameter (inches) 2"
- (2) total depth (feet) 70'
- (3) static water level (feet) 40' below above top of ground.

- (4) casing PVC 65' (material) (depth)

(size) If telescope see back.

- (5) screen 5' 65' (length) (depth to top)

2" PVC (size) (material)

- (6) pump 1 12 (HP) (yield gpm)

SBEP (type power)

- (7) electric log no (yes or no)

(organization running log)

- (8) how well bottom plugged PVC brace wash water

DRILLERS REMARKS:


RECEIVED  
OCT 23 1989

Department of Natural Resources  
Bureau of Land & Water Resources

If well telescopes please sketch and show depths.

GROUND LEVEL

926

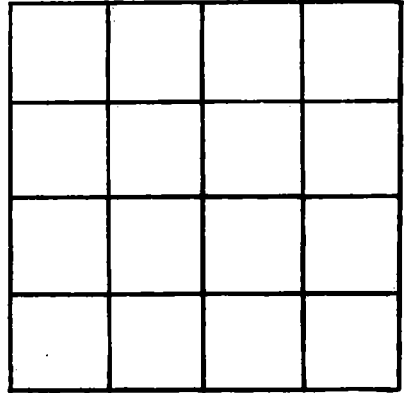

SECTION \_\_\_\_\_

Please indicate well location X.

ADDITIONAL INFORMATION

A series of horizontal lines providing space for additional information.

If more than one screen, show locations of each on sketch.