

**MISSISSIPPI DEPARTMENT OF ENVIRONMENTAL QUALITY**

Office of Land and Water Resources

P. O. Box 10631  
Jackson, MS 39289-0631  
**WATER WELL DRILLERS LOG**

COUNTY WELL LOCATED <u>Jackson</u>	
WELL NUMBER <u>H 2138</u>	CODED
DATE WELL COMPLETED <u>3-5-97</u>	

PERMIT NUMBER
NAME OF DRILLING FIRM <u>Pierce Well</u>

NAME & MAILING ADDRESS OF LANDOWNER <u>Mike Slater</u>			
<u>Frank Small Rd.</u>			
<u>Pascagoula Ms</u>			
WELL LOCATION	SEC	TOWNSHIP	RANGE
	<u>10</u>	<u>5 N</u>	<u>5 W</u>
DISTANCE	DIRECTION	NEAREST TOWN	
<u>3</u> Miles	<u>S</u>	of <u>Hurley</u>	
OTHER LANDMARK			
WELL PURPOSE <input checked="" type="checkbox"/> Home Irrigation, <input type="checkbox"/> Municipal, <input type="checkbox"/> Industrial, <input type="checkbox"/> Fish Pond, etc.			

<b>PUMP DATA</b>		
PUMP TYPE (Circle One): Submersible, Turbine, <input checked="" type="radio"/> Jet, <input type="radio"/> Flowing Well, Other (Describe) _____		
POWER TYPE (Circle One): <input checked="" type="radio"/> Electric, <input type="radio"/> Tractor, <input type="radio"/> Diesel, <input type="radio"/> Gasoline, <input type="radio"/> Butane, Other (Describe) _____ H/P <u>1</u>		
Pump Capacity (GPM) <u>10</u>	No. of Stages <u>2</u>	Setting Depth <u>40</u> FT.
PUMP TEST		
Well yielded <u>10</u> GPM with a drawdown of <u>10</u> ft. after <u>1</u> hours of pumping		

<b>WELL DATA</b>		
Well Depth <u>70'</u>	Casing Diameter (In.) <u>2"</u>	Casing Length (Ft.) <u>60'</u>
Type of Casing <u>Plastic</u>	Hole Depth <u>70'</u>	Depth to Static Water Level <u>20'</u>
TYPE OF COMPLETION: (Circle One or More): <input checked="" type="checkbox"/> Gravel Packed, <input type="checkbox"/> Underreamed, <input type="checkbox"/> Telescoped, <input checked="" type="checkbox"/> Natural Development, <input type="checkbox"/> Open Hole, <input type="checkbox"/> Other (Describe) _____		
WELL GROUTED TO A DEPTH OF <u>15 FEET</u> Type Grout (circle one): <input checked="" type="checkbox"/> Cement, <input type="checkbox"/> Bentonite, <input type="checkbox"/> Mix		

<b>LOG DATA</b>	
TYPE OF LOG RUN (Circle One): Electric, Gamma Ray, Density, Sonic, Neutron, Other (Describe) _____ <input checked="" type="radio"/> No Log Run.	
Name of Organization Running Log	

<b>GEOLOGIC DATA (Office Use Only)</b>			
Surface Elev.	Geologic Unit	Unit Thickness	Depth to Top
Subs. SWL	Date	Analysis	Aquifer Test
Driller's Remarks			
Top of Lap Pipe or Reduction in Casing			
FEET		IF TELESCOPED OR MORE THAN ONE SCREEN: USE BACK PAGE	


<b>SCREEN DATA</b>		
Diameter - Inches <u>2 1/2"</u>	Length - Feet <u>10'</u>	Slot Size - Inches <u>006</u>
Screen Type <u>Plastic</u>	Depth to Bottom - Feet <u>70'</u>	

DESCRIPTION OF FORMATIONS ENCOUNTERED	FROM	TO
<u>Top soil</u>	<u>0</u>	<u>10</u>
<u>clay</u>	<u>10</u>	<u>20</u>
<u>Sand</u>	<u>20</u>	<u>40</u>
<u>clay</u>	<u>40</u>	<u>60</u>
<u>good sand</u>	<u>60</u>	<u>80</u>

FORMATIONS (Continued)	FROM	TO
<b>RECEIVED</b>		
<b>JUN 05 1997</b>		
Dept. of Environmental Quality Office of Land & Water Resources		
IF MORE SPACE IS NEEDED, USE BACK		

If well telescopes please  
sketch and show depths.

GROUND LEVEL

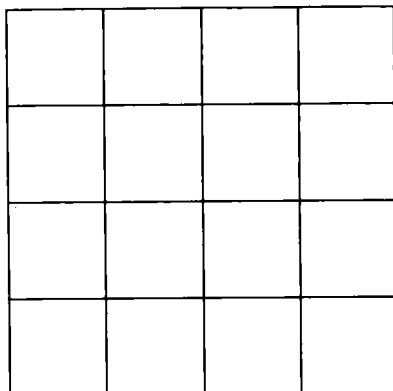

SECTION \_\_\_\_\_

Please indicate well location X.

ADDITIONAL INFORMATION

If more than one screen,  
show location of each on sketch.