

MISSISSIPPI DEPARTMENT OF ENVIRONMENTAL QUALITY

Office of Land and Water Resources

P. O. Box 10631
Jackson, MS 39289-0631
WATER WELL DRILLERS LOG

COUNTY WELL LOCATED
Jackson

WELL NUMBER: **H 2151** (CODED)

DATE WELL COMPLETED
11-28-97

PERMIT NUMBER

NAME OF DRILLING FIRM
Coast Water Well Service

NAME & MAILING ADDRESS OF LANDOWNER
**Kelly Stacks
Hotfield Rd.
Hurley Ms**

WELL LOCATION SEC TOWNSHIP RANGE
10 5 N 5 E

DISTANCE DIRECTION NEAREST TOWN
2 Miles SE of Hurley

OTHER LANDMARK

WELL PURPOSE: Home, Irrigation, Municipal, Industrial, Fish Pond, etc.

PUMP DATA

PUMP TYPE (Circle One):
Submersible, Turbine, **Flowing Well**, Other (Describe) _____

POWER TYPE (Circle One):
 Electric, Tractor, Diesel, Gasoline, Butane, Other (Describe) _____ H/P **1**

Pump Capacity (GPM) 10	No. of Stages 2	Setting Depth FT.
----------------------------------	---------------------------	-----------------------------

PUMP TEST

Well yielded _____ GPM with a drawdown of _____ ft. after _____ hours of pumping

WELL DATA

Well Depth 80	Casing Diameter (In.) 2"	Casing Length (Ft.) 70'
Type of Casing PVC	Hole Depth 80'	Depth to Static Water Level 10'

LOG DATA

TYPE OF LOG RUN (Circle One):
Electric, Gamma Ray, Density, Sonic, **No Log Run**, **Neutron**, Other (Describe) _____

Name of Organization Running Log

TYPE OF COMPLETION: (Circle One or More):
 Natural Development, Gravel Packed, Underreamed, Telescoped, Open Hole, Other (Describe) _____

WELL GROUTED TO A DEPTH OF **20** FEET
Type Grout (circle one): **Cement**, Bentonite, or Mix

GEOLOGIC DATA (Office Use Only)

Surface Elev.	Geologic Unit	Unit Thickness	Depth to Top
Subs. SWL	Date	Analysis	Aquifer Test

SCREEN DATA

Diameter - Inches 2"	Length - Feet 10'	Slot Size - Inches .008
Screen Type PVC	Depth to Bottom - Feet 80'	

Driller's Remarks

Top of Lap Pipe or Reduction in Casing

FEET IF TELESCOPED OR MORE THAN ONE SCREEN: USE BACK PAGE

DESCRIPTION OF FORMATIONS ENCOUNTERED	FROM	TO
Top Soil	0	2
White Coarse sand	2	30
White Clay	30	33
White Coarse sand	33	80

FORMATIONS (Continued) FROM TO

RECEIVED


FEB 06 1998

**Dept. of Environmental Quality
Office of Land & Water Resources**

IF MORE SPACE IS NEEDED, USE BACK

If well telescopes please sketch and show depths.

GROUND LEVEL

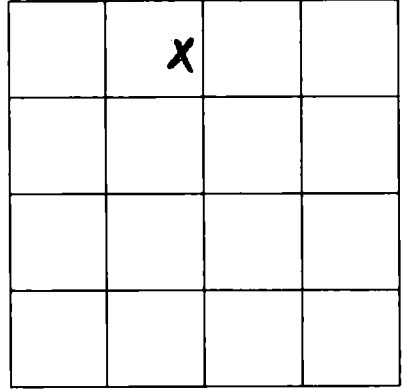

SECTION 10

Please indicate well location X.

ADDITIONAL INFORMATION

Lined area for additional information, consisting of approximately 20 horizontal lines.

RECEIVED

If more than one screen, show location of each on sketch.