

MISSISSIPPI DEPARTMENT OF ENVIRONMENTAL QUALITY

Office of Land and Water Resources

P. O. Box 10631
Jackson, MS 39289-0631

WATER WELL DRILLERS LOG

COUNTY WELL LOCATED <i>Jackson</i>	
WELL NUMBER <i>H2167</i>	CODED
DATE WELL COMPLETED <i>6-10-99</i>	

PERMIT NUMBER
NAME OF DRILLING FIRM <i>Pierce Well</i>

NAME & MAILING ADDRESS OF LANDOWNER <i>Bruce Bardwell</i> <i>Frank Snell Rd.</i> <i>Hurley, Ms</i>			
WELL LOCATION	SEC	TOWNSHIP	RANGE
	<i>11</i>	<i>5</i>	<i>5</i>
DISTANCE	DIRECTION	NEAREST TOWN	
<i>2 1/2</i> Miles	<i>S</i>	of <i>Hurley</i>	
OTHER LANDMARK			
WELL PURPOSE <input checked="" type="checkbox"/> Home Irrigation, <input type="checkbox"/> Municipal, <input type="checkbox"/> Industrial, <input type="checkbox"/> Fish Pond, etc.			

PUMP DATA		
PUMP TYPE (Circle One): Submersible, Turbine, <input checked="" type="radio"/> Jet, Flowing Well, Other (Describe) _____		
POWER TYPE (Circle One): <input checked="" type="radio"/> Electric, Tractor, Diesel, Gasoline, <input type="radio"/> Butane, Other (Describe) _____ H/P _____		
Pump Capacity (GPM) <i>10</i>	No. of Stages <i>2</i>	Setting Depth <i>40</i> FT.
PUMP TEST		
Well yielded _____ <i>10</i> GPM with a drawdown of _____ <i>10</i> ft. after _____ <i>1</i> hours of pumping		

WELL DATA		
Well Depth <i>65'</i>	Casing Diameter (In.) <i>2"</i>	Casing Length (Ft.) <i>55</i>
Type of Casing <i>Plastic</i>	Hole Depth <i>65'</i>	Depth to Static Water Level <i>20'</i>
TYPE OF COMPLETION: (Circle One or More): <input checked="" type="checkbox"/> Gravel Packed, <input type="checkbox"/> Underreamed, <input type="checkbox"/> Telescoped, <input checked="" type="checkbox"/> Natural Development, <input type="checkbox"/> Open Hole, <input type="checkbox"/> Other (Describe) _____		
WELL GROUTED TO A DEPTH OF <i>15</i> FEET Type Grout (circle one): Cement, Bentonite, or Mix		

LOG DATA	
TYPE OF LOG RUN (Circle One): Electric, Gamma Ray, Density, Sonic, <input checked="" type="radio"/> No Log Run, Other (Describe) _____	
Name of Organization Running Log	

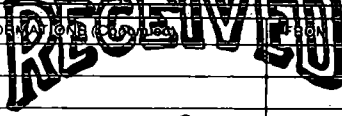
SCREEN DATA			
Diameter - Inches <i>2"</i>	Length - Feet <i>10</i>	Slot Size - Inches <i>006</i>	
Screen Type <i>Plastic</i>		Depth to Bottom - Feet <i>65'</i>	

GEOLOGIC DATA (Office Use Only)			
Surface Elev.	Geologic Unit	Unit Thickness	Depth to Top
Subs. SWL	Date	Analysis	Aquifer Test

SCREEN DATA			
Diameter - Inches <i>2"</i>	Length - Feet <i>10</i>	Slot Size - Inches <i>006</i>	
Screen Type <i>Plastic</i>		Depth to Bottom - Feet <i>65'</i>	

Driller's Remarks			
Top of Lap Pipe or Reduction in Casing			
FEET			
IF TELESCOPED OR MORE THAN ONE SCREEN USE THIS PAGE			

DESCRIPTION OF FORMATIONS ENCOUNTERED	FROM	TO
<i>Top Soil</i>	<i>0</i>	<i>10</i>
<i>Clay</i>	<i>10</i>	<i>30</i>
<i>Good Sand</i>	<i>30</i>	<i>65</i>

 NOV 10 1999 Dept. of Environmental Quality Office of Land & Water Resources			
IF MORE SPACE IS NEEDED, USE BACK			

If well telescopes please sketch and show depths.

GROUND LEVEL

SECTION _____

Please indicate well location X.

ADDITIONAL INFORMATION

RECEIVED

2000

UNIT OF ENVIRONMENTAL HEALTH
COUNTY OF LARSEN & BAKER

If more than one screen,
show location of each on sketch.