

MISSISSIPPI DEPARTMENT OF ENVIRONMENTAL QUALITY

QUALITY

Office of Land and Water Resources

P. O. Box 10631
Jackson, MS 39289-0631

WATER WELL DRILLERS LOG

COUNTY - WELL LOCATED Jackson	
WELL NUMBER A-2191	CODED
DATE WELL COMPLETED 2-7-01	

PERMIT NUMBER
NAME OF DRILLING FIRM Coast Water Well

NAME & MAILING ADDRESS OF LANDOWNER Bart Walker			
Broken Arrow Estates			
Hurley, Ms			
WELL LOCATION	SEC	TOWNSHIP	RANGE
	6	5	5
DISTANCE	DIRECTION	NEAREST TOWN	
2 Miles	SW	of Hurley	
OTHER LANDMARK			
WELL PURPOSE: Home, Irrigation, Municipal, Industrial, Fish Pond, etc. <input checked="" type="radio"/> Home			

PUMP DATA		
PUMP TYPE (Circle One): Submersible, Turbine, <input checked="" type="radio"/> Jet, Flowing Well, Other (Describe) _____		
POWER TYPE (Circle One): <input checked="" type="radio"/> Electric, Tractor, Diesel, Gasoline, Butane, Other (Describe) _____ H/P 1		
Pump Capacity (GPM) 8.5	No. of Stages 2	Setting Depth _____ FT.
PUMP TEST Well yielded _____ GPM with a drawdown of _____ ft. after _____ hours of pumping		

WELL DATA		
Well Depth 355'	Casing Diameter (In) 2"	Casing Length (Ft) 340'
Type of Casing PVC	Hole Depth 355'	Depth to Static Water Level 10'
TYPE OF COMPLETION: (Circle One or More): <input checked="" type="radio"/> Gravel Packed, <input checked="" type="radio"/> Natural Development, <input type="radio"/> Underreamed, <input type="radio"/> Telescoped, <input type="radio"/> Open Hole, <input type="radio"/> Other		
WELL GROUTED TO A DEPTH OF 10 FEET Type Grout (circle one): Cement, <input checked="" type="radio"/> Bentonite, or Mix		

LOG DATA	
TYPE OF LOG RUN (Circle One): Electric, Gamma Ray, Density, Sonic, <input checked="" type="radio"/> No Log Run, Neutron, Other (Describe) _____	
Name of Organization Running Log	

SCREEN DATA		
Diameter - Inches 2"	Length - Feet 15'	Slot Size - Inches .004
Screen Type PVC	Depth to Bottom - Feet 355'	


GEOLOGIC DATA (Office Use Only)			
Surface Elev.	Geologic Unit	Unit Thickness	Depth to Top
Subs. SWL	Date	Analysis	Aquifer Test
Driller's Remarks			
Top of Lap Pipe or Reduction in Casing _____ FEET IF TELESCOPED OR MORE THAN ONE SCREEN: USE BACK PAGE			

DESCRIPTION OF FORMATIONS ENCOUNTERED	FROM	TO	FORMATIONS (Continued)	FROM	TO
Top Soil	0	2			
White Coarse Sand	2	60			
Orange Clay	60	70			
White Coarse Sand	70	95			
Blue Clay Streak of sand	95	330			
Medium Sand	330	355			

REC'D MAY 17 2001

If well telescopes please
sketch and show depths.

GROUND LEVEL

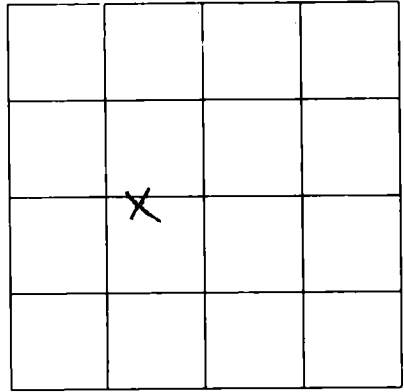

SECTION 6

Please indicate well location X.

ADDITIONAL INFORMATION

If more than one screen,
show location of each on sketch.