

Jackson  
H  
10-63

MISSISSIPPI BOARD OF WATER COMMISSIONERS

Can't locate

WATER WELL DRILLERS LOG

Date: OCT 1, 1963, Driller: George Colville County: Jackson

(Name)

(1) Owner of Land: CLEVELAND & DeMORRIS CUMBEST  
(Name)  
Wade, Miss  
(Address)

(2) Location: NW 1/4, SW 1/4, Sec. 14 T35R5W  
18 miles N of MOSS POINT  
(distance) (direction) (Nearest Town)

(3) Topography: FLAT  
(Hilly) (Flat) (Level)

(4) Purpose of Well: DOM  
(Domestic Irrigation  
Municipal, Industrial, Other)

Description & Color of Materials Sand, Clay, Red Clay, Shell, etc.	Thick- ness Feet	Depth Feet
Red CLAY	16	16
SAND	2	18
CLAY	4	22
SAND	02	44
GRAVEL	55	99
BLUE CLAY	295	396
FINE SAND	22	418
CLAY	22	440
FINE SAND	22	462
FINE SAND	22	484
CLAY	78	562
FINE SAND	10	572
CLAY	193	765
SANDY CLAY	5	770
FINE SAND	12	782
SAND	38	820

Information upon completion of well:

(1) Diameter 2 inches.

(2) Total Depth 820 feet.

(3) Water Level +19'-8" ABOVE feet below top of ground.


(4) Cased to 810, Size 2 IN.

(5) Screen: Size .008, Length 10'

(6) Were any formations sealed against pollution?  
\_\_\_\_\_ yes,  no.

If YES depth of formation \_\_\_\_\_  
Why \_\_\_\_\_

Drillers Remarks: \_\_\_\_\_

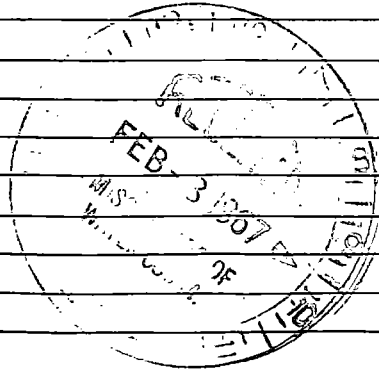

(Use Back Side)

Well No.  
266

