

TARRISON

M 0006


6-3-64

WATER WELL DRILLERS LOG

Date: June 3, 1964, Driller: C. T. SWITZER WELL CO County Jackson

(Name)

(1) Owner of Land: Cedar Grove High School (Name)	Description & Color of Materials Sand, Clay, Red Clay, Shell, etc.	Thick- ness Feet	Depth Feet
	Clay	00	82
(2) Location: Old Highway 90 N. Belzoni (Address)	Sand	82	94
	Clay	94	116
(2) Location: 1/4, 1/4, Sec. T R	Clay	116	126
	W/ sand other	126	146
_____ miles _____ of _____	Clay	146	181
(3) Topography: (Hilly) (Flat) (Level)	Sand	181	201
(4) Purpose of Well: Commercial	Clay	201	366
(Domestic Irrigation Municipal, Industrial, Other)	Sand	366	370
Information upon completion of well:	Sand, good	370	390
(1) Diameter 4x6 inches.	Clay	390	395
(2) Total Depth 792 feet.	Sand, fine	395	410
(3) Water Level 4 1/2 + feet below top of ground.	Sand	410	415
(4) Cased to 792, Size 4x6	Shale	415	431
(5) Screen: Size 4", Length 40'	Shale + sand	431	471
(6) Were any formations sealed against pollution?	Shale + sand other	471	491
X yes, no.	Shale	491	511
If YES depth of formation _____	Shale w/ layer rocks	511	551
Why Health Dept Requirement _____	Shale w/ sand other	551	591
Drillers Remarks: _____	Shale	591	599
_____	Sand	599	642
_____	Shale	642	693
_____	Sand	693	791

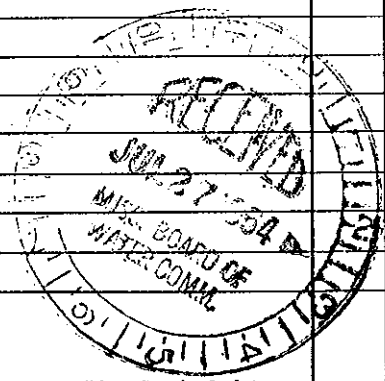

(Use Back Side)

Well No.

Mail this copy to Board of Water Commissioners 429 Miss. St. Jackson, Miss.