

J 42

WATER WELL DRILLERS LOG

11-6-61

Date: Nov 6, 1961, Driller: Colville County Jackson
 45 (Name)

(1) Owner of Land: A.R. Myers
 (Name)
Ocean Springs
 (Address)

(2) Location: SW 1/4, NW 1/4, Sec. 35 T6SR9W
7 miles North of Ocean Springs
 (distance) (direction) (Nearest Town)

(3) Topography: Hilly
 (Hilly) (Flat) (Level)

(4) Purpose of Well: Housing Project
 (Domestic Irrigation
 Municipal, Industrial, Other)

Description & Color of Materials Sand, Clay, Red Clay, Shell, etc.	Thick- ness Foot	Depth Foot
Clay		21
Sand, clay & rock strks	21	42
Clay	42	84
Sand	11	95
Clay	94	189
Sand	105	194
Clay	142	336
FINE Sand	21	357
Clay	123	480
SAND	3	483
Clay	169	652
SANDSTONE	4	656
Clay	54	710
SAND	4	714
Clay	26	740
SAND	16	756
Clay	53	809
SAND (strks)	10	819
Clay	57	876
SAND	69	945
		TD

Information upon completion of well:

(1) Diameter 2 inches.

(2) Total Depth 945 feet.

(3) Water Level +25'-2" feet below top of ground.

(4) Cased to _____, Size _____


(5) Screen: Size 2", Length 20'

(6) Were any formations sealed against pollution?
 _____ yes, _____ no.

If YES depth of formation _____

Why _____

Drillers Remarks: _____

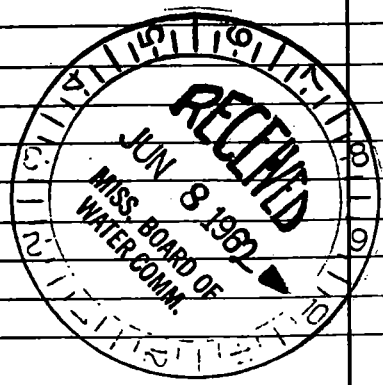

(Use Back Side)

Well No 81

yin

Table 1. Summary of the study.

Variable	Value
Sample size	100
Mean	5.2
Standard deviation	1.8

Table 2. Descriptive statistics.

Variable	Mean	SD
Score 1	4.5	1.2
Score 2	5.1	1.5
Score 3	4.8	1.3

