

JACKSON MISSISSIPPI BOARD OF WATER COMMISSIONERS

J 45

4-12-63

WATER WELL DRILLERS LOG

Date: 4-12, 1963, Driller: M & B Drilling Co., County Jackson

45

(1) Owner of Land: Trent Eaton
 (Name)
P.R. Ocean Springs, Miss.
 (Address)

(2) Location: 1/4 SW 1/4, Sec. 30 T52R6
5 miles North of Ocean Springs
 (distance) (direction) (Nearest Town)

(3) Topography: Flat
 (Hilly) (Flat) (Level)

(4) Purpose of Well: Domestic
 (Domestic Irrigation
 Municipal, Industrial, Other)

Description & Color of Materials Sand, Clay, Red Clay, Shell, etc.	Thick- ness Feet	Depth Feet
Red Clay	18	14
Black Clay	11	25
Orange Sand & Clay Brack	20	45
Blue Clay	121	66
Fine Sand	12	178
Blue Clay	42	220
Fine Sand	10	230
Blue Clay	20	250
Fine Sand	8	258
Blue Clay	8	266
Medium Sand	4	270
Blue Clay	136	406
Coarse Sand & Fine Gravel	14	420

Information upon completion of well:

(1) Diameter 2 inches.

(2) Total Depth 420 feet.


(3) Water Level 17 feet below top of ground.

(4) Cased to 410, Size 2"

(5) Screen: Size 2" x 8/16" T Length 10 FT.

(6) Were any formations sealed against pollution?
 _____ yes, _____ no.

If YES depth of formation _____
 Why _____
 Drillers Remarks: _____

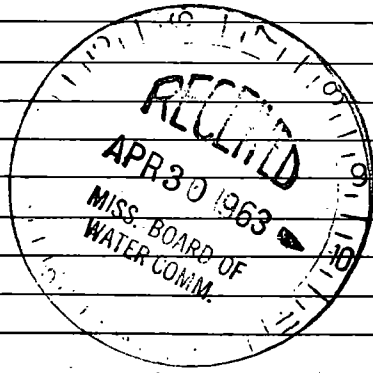

(Use Back Side)

Well No.

