

Jackson

J50

MISSISSIPPI BOARD OF WATER COMMISSIONERS

9-66

4 0

WATER WELL DRILLERS LOG

Jackson


Date: 9-2, 1966, Driller: C.T. Switzer Well Co. County: Jackson

(When well drilled)

(Name)

(Where well is located)

| | Description & Color of Materials Sand, Clay, Red Clay, Shell, etc. | Thick- ness Feet | Depth Feet |
|--|---|------------------------|---------------|
| (1) Owner of Land: Mrs. Coy Taylor | clay topsoil | 0 | 8 |
| 505 Graham Ave. Biloxi | sand | 8 | 11 |
| 2 miles N. of (Address) Tucker Road | clay | 11 | 21 |
| (2) Location: NE 1/4, NE 1/4, Sec. 14 T6SR2W | soft clay + sand | 21 | 43 |
| _____ miles _____ of _____ | clay | 43 | 168 |
| (3) Topography: X | fine sand | 168 | 189 |
| (Hilly) (Flat) (Level) | clay | 189 | 327 |
| (4) Purpose of Well: domestic | sand | 327 | 334 |
| (Domestic Irrigation Municipal, Industrial, Other) | clay | 334 | 395 |
| Information upon completion of well: | clay + sand streaks | 395 | 416 |
| (1) Diameter: 2 inches. | clay | 416 | 701 |
| (2) Total Depth: 768 feet. | shale + sand streaks | 701 | 721 |
| (3) Water Level: 7 feet below top of ground. | good sand | 721 | 768 |
| (4) Cased to: 768', Size: 2" | | | |
| (5) Screen: Size: 10 ga SS, Length: 10' | | | |
| (6) Were any formations sealed against pollution? | | | |
| X yes, _____ no. | | | |
| If YES depth of formation _____ | | | |
| Why: Health Dept. Regments. | | | |
| Drillers Remarks: _____ | | | |
| Yield in gpm: _____ | | | |
| Size pump: _____ | | | |
| Type power: _____ | | | |

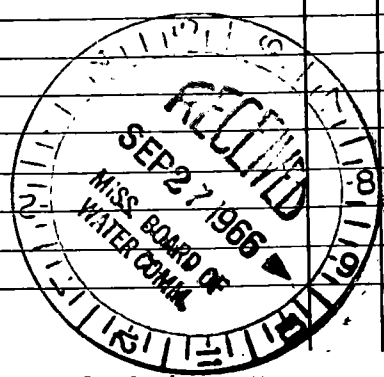

Mail this copy to Board of Water Commissioners 429 Miss. St. Jackson, Miss.

