

JACKSON
 T 51
 9-66

MISSISSIPPI BOARD OF WATER COMMISSIONERS

WATER WELL DRILLERS LOG

Date: 9-27, 1966, Driller C.T. Switzer Well Co. County Jackson
45 (When well drilled) (Name) (Where well is located)

(1) Owner of Land: James T. Arrowood
 (Name)
Pl. 1, Ocean Springs, on John
Mc Cormick Rd 1/2 mile
W. Biloxi Rd. (Address)
 (2) Location: NW 1/4, NW 1/4, Sec. 10 T6^s R7^w
 _____ miles _____ of _____
 (distance) (direction) (Nearest Town)
 (3) Topography: X
 (Hilly) (Flat) (Level)
 (4) Purpose of Well: domestic
 (Domestic Irrigation
 Municipal, Industrial, Other)

Description & Color of Materials Sand, Clay, Red Clay, Shell, etc.	Thick- ness Feet	Depth Feet
sandy soil	0	6
clay	6	12
sand	12	31
clay	31	62
clay with fine sand streaks	62	83
fine sand	83	115
clay	115	249
clay with sand streaks	249	276
clay	276	276
fine sand	276	287
clay	287	363
good sand	363	393
clay + Fuller's Earth	393	411
clay	411	449
sand	449	492

Information upon completion of well:

(1) Diameter 2 inches.
 (2) Total Depth 492 feet.
 (3) Water Level 18 feet below top of ground.
 (4) Cased to 492', Size 2"
 (5) Screen: Size 8ga SS, Length 10'
 (6) Were any formations sealed against pollution?
X yes, _____ no.

If YES depth of formation _____


Why Health Dept. Reagents

Drillers Remarks: _____

Yield in gpm: _____

Size pump: _____

Type power: _____

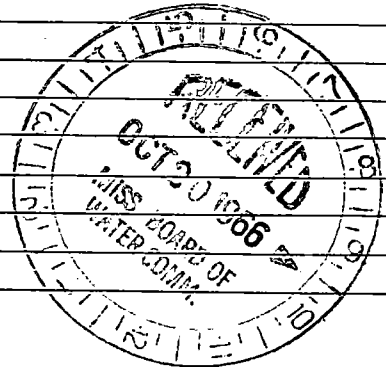

Mail this copy to Board of Water Commissioners 429 Miss. St. Jackson, Miss.

