

60 350 6

Jackson
T 52
3-67

MISSISSIPPI
BOARD OF WATER COMMISSIONERS
416 North State Street
Jackson, Mississippi 39201

WATER WELL DRILLERS LOG

324 19 67 HATTIESBURG BUTANE JACKSON
date well completed firm name county well located


LANDOWNER: H. H. Broadway
RFD Box 23
5050, Miss.
(mailing address)

WELL LOCATION:
sec. 3 T 6 S R 9 W
10 miles North Dear Springs
(distance) (direction) (nearest town)

WELL PURPOSE: Home
(home, irrigation, municipal, industrial)

- WELL COMPLETION DATA:
- (1) diameter (inches) 2"
 - (2) total depth (feet) 340
 - (3) static water level (feet) 64' below
top of ground.
 - (4) casing Galv. pipe 3.27'
(material) (depth)
2"
(size) if telescope see back.
 - (5) screen 10' 330'
(length) (depth to top)
2" Bronze
(size) (material)
 - (6) pump 1 350
(HP) (yield gpm)
electric
(type power)
 - (7) electric log no
(yes or no)
no
(organization running log)
 - (8) how well bottom plugged
Back wash Valve

description of formations encountered	from to	
	feet	feet
yellow sand	0	8
white sand	8	12
white clay	12	25
Blue Clay	25	30
yellow clay & yellow sand	30	38
yellow clay	38	40
Blue clay	40	50
Blue sand	50	81
Blue Clay	81	90
Blue sand	90	95
Blue Clay	95	158
Blue sand & black	158	320
Blue sand	320	340

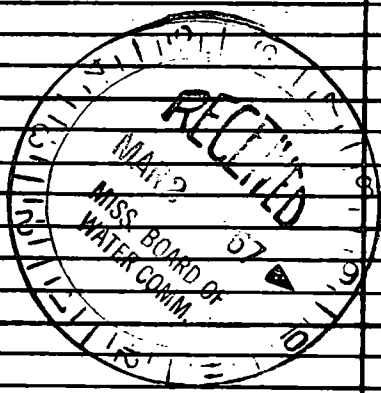

DRILLERS REMARKS:

If well telescopes please sketch and show depths.

SW SE

GROUND LEVEL

[Handwritten notes and sketches in the ground level section, including various scribbles and faint lines.]

[A 4x4 grid with an 'X' marked in the bottom-right quadrant.]

SECTION 3

Please indicate well location X.

ADDITIONAL INFORMATION

[A series of horizontal lines for additional information, with some faint handwritten notes.]

If more than one screen, show locations of each on sketch.