

35

60 500
480 8

Jackson
T 53
4-67

MISSISSIPPI
BOARD OF WATER COMMISSIONERS
416 North State Street
Jackson, Mississippi 39201

WATER WELL DRILLERS LOG

4-25 1967 Coastal Water Well Driller Jackson
date well completed firm name county well located

LANDOWNER: Shirley Balks

description of formations encountered	from	to
Red Clay	0	30
Blue Clay	30	158
Sand Gravel	158	173

Ocean Springs, Miss
Rural Route
(mailing address)


WELL LOCATION:
sec. 26 T. 4 N R. 8 E
S W
8 miles NE of Ocean Springs
(distance) (direction) (nearest town)

WELL PURPOSE: Home
(home, irrigation, municipal, industrial)

- WELL COMPLETION DATA:
- (1) diameter (inches) 1 1/4" x 2"
 - (2) total depth (feet) 173
 - (3) static water level (feet) 12 below top of ground.
 - (4) casing Galv. 168 (material) (depth)
1 1/4" x 2" (size) (telescope) see back.
 - (5) screen 5' 168 (length) (depth to top)
1 1/4" Brass (size) (material)
 - (6) pump 1/2 500 (HP) (yield gpm)
Elect (type power)
 - (7) electric log NO (yes or no)
(organization running log)

(8) how well bottom plugged
Back Wash Valve

DRILLERS REMARKS:

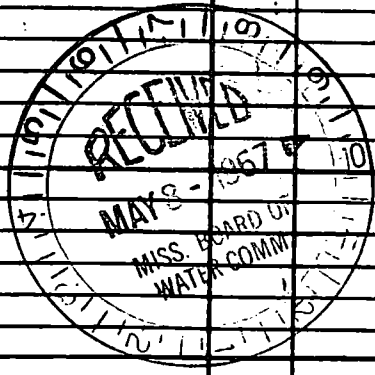


If well telescopes please sketch and show depths.

GROUND LEVEL

21 ft
2" galv

← Bell
← Rodman

← 1 1/4 galv

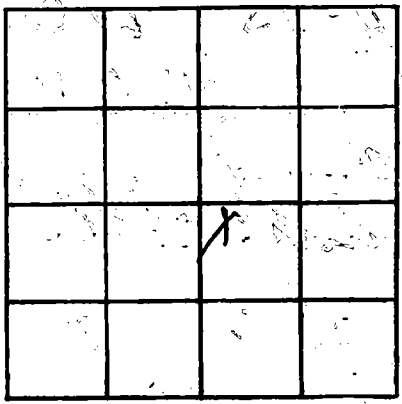

SECTION 26

Please indicate well location X.

ADDITIONAL INFORMATION

If more than one screen, show locations of each on sketch.