

1/2 mile off road on  
The Cormick Road


JACKSON  
J 55  
4-68

MISSISSIPPI  
BOARD OF WATER COMMISSIONERS  
416 North State Street  
Jackson, Mississippi 39201

WATER WELL DRILLERS LOG


4-27 1968 date well completed  
Switzer Well Co. firm name  
Jackson county well located

LANDOWNER: <u>Robert Wilson</u>	description of formations encountered	from	to
<u>The Cormick Road</u>	clay	0	18
<u>Ocean Springs Miss.</u> (mailing address)	sand	18	32
	clay	32	63
	mixed	63	104
WELL LOCATION:	clay	104	139
sec. <u>10</u> T. <u>6</u> S. R. <u>9</u> E. W.	fine sand	139	145
<u>6 1/2</u> miles <u>N</u> of <u>Biloxi</u>	sand	145	153
(distance) (direction) (nearest town)	fine clay	153	166
	clay	166	187
WELL PURPOSE: <u>Home</u> (home, irrigation, municipal, industrial)	mixed	187	206
	clay	206	227
WELL COMPLETION DATA:	mixed	227	248
(1) diameter (inches) <u>2"</u>	sand	248	261
(2) total depth (feet) <u>469'</u>	clay	261	268
(3) static water level (feet) <u>9'7"</u> above top of ground.	mixed	268	289
(4) casing <u>gal. steel 459'</u> (material) (depth)	clay	289	309
<u>2"</u> (size) If telescope see back.	fine sand	309	329
(5) screen <u>10'</u> <u>459'</u> (length) (depth to top)	sand	329	343
<u>8 ga. ss on pipe</u> (size) (material)	clay	343	370
(6) pump <u>not installed</u> (HP) (yield gpm)	mixed	370	389
(type power)	clay	389	417
(7) electric log <u>No</u> (yes or no)	fine sand	417	430
(organization running log)	good sand	430	469
(8) how well bottom plugged <u>Back</u> <u>pressure valve</u>			
DRILLERS REMARKS:			

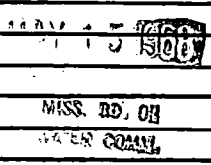

If well telescopes please sketch and show depths.

GROUND LEVEL

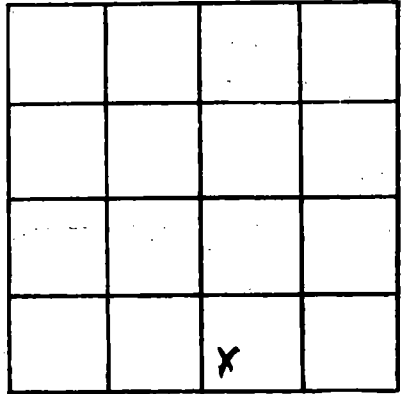

SECTION 10

Please indicate well location X.

ADDITIONAL INFORMATION

If more than one screen, show locations of each on sketch.