

CODER

MISSISSIPPI
BOARD OF WATER COMMISSIONERS
416 North State Street
Jackson, Mississippi 39201

WATER WELL DRILLERS LOG

Jackson
857
7-22-68

7-22 1968 Coast Water Well Serv. Jackson
date well completed firm name county well located

LANDOWNER: J. E. Noble
Route #2 Box 378
Ocean Springs Miss.
(mailing address)

description of formations encountered	from	to
<u>Red Clay & fine sand</u>	<u>0</u>	<u>30</u>
<u>Blue Clay</u>	<u>30</u>	<u>42</u>
<u>Sand Gravel</u>	<u>42</u>	<u>57</u>
<u>Blue Clay & sand shale</u>	<u>57</u>	<u>148</u>
<u>sand red-clay</u>	<u>148</u>	<u>178</u>

WELL LOCATION:
sec. 26 T. 6 N. R. 8 E.
S W
5 miles SW of Vandover
(distance) (direction) (nearest town)

WELL PURPOSE: Home
(home, irrigation, municipal, industrial)

- WELL COMPLETION DATA:
- (1) diameter (inches) 2"
 - (2) total depth (feet) 178
 - (3) static water level (feet) 21 below above top of ground.
 - (4) casing galv. 168'
(material) (depth)
2"
(size) if telescope see back.
 - (5) screen 10' 168'
(length) (depth to top)
2" wrapped stainless
(size) (material)
 - (6) pump 1/4 8
(HP) (yield gpm)
Elec.
(type power)
 - (7) electric log NO
(yes or no)

(organization running log)
 - (8) how well bottom plugged Back
Wash Valve

CODER


DEC 30 1968

MISS. BD. OF
WATER COM.

DRILLERS REMARKS:

If well telescopes please sketch and show depths.

GROUND LEVEL

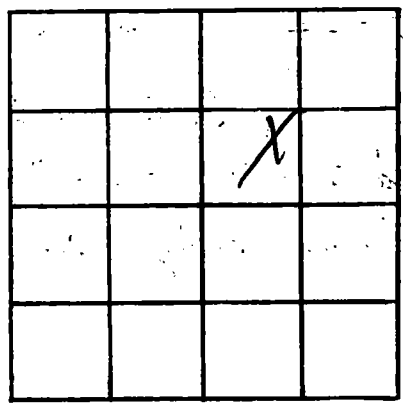

SECTION 26

Please indicate well location X.

ADDITIONAL INFORMATION

Multiple horizontal lines for writing additional information.

If more than one screen, show locations of each on sketch.