

JACKSON
 J 58
 4-23-71

MISSISSIPPI
 BOARD OF WATER COMMISSIONERS
 416 North State Street
 Jackson, Mississippi 39201

CODED

WATER WELL DRILLERS LOG

4-23
 date well completed

1971 Coast Water Well Service
 firm name

Jackson
 county well located

LANDOWNER: <u>A. A. Mc Lulland</u>	description of formations encountered	from	to
<u>Rt. 2 Box 369 A</u>	<u>top soil + clay</u>	<u>0</u>	<u>42</u>
<u>Ocean Springs, Miss.</u> (mailing address)	<u>sand - med to coarse</u>	<u>42</u>	<u>101</u>

WELL LOCATION:
 sec. 25 T. 6 N. R. 8 W.
5 miles SW of Worcester
 (distance) (direction) (nearest town)

<u>blue clay w/ sand streaks</u>	<u>101</u>	<u>200</u>
<u>sand - fine to med.</u>	<u>200</u>	<u>224</u>

WELL PURPOSE: private pump
 (home, irrigation, municipal, industrial)

- WELL COMPLETION DATA:
- (1) diameter (inches) 2"
 - (2) total depth (feet) 224
 - (3) static water level (feet) 15 below top of ground.
 - (4) casing P.V.C., 220
 (material) (depth)
2" if telescope see back.
 (size)
 - (5) screen 4', 220
 (length) (depth to top)
2", all stainless
 (size) (material)
 - (6) pump 1, 12
 (HP) (yield gpm)
elec.
 (type power)
 - (7) electric log no
 (yes or no)
 (organization running log)
 - (8) how well bottom plugged
nearest last valve

CODED


MAY 5 - 1971

DRILLERS REMARKS:

MISS. BD. OF
 WATER COMMISSIONERS

If well telescopes please sketch and show depths.

GROUND LEVEL

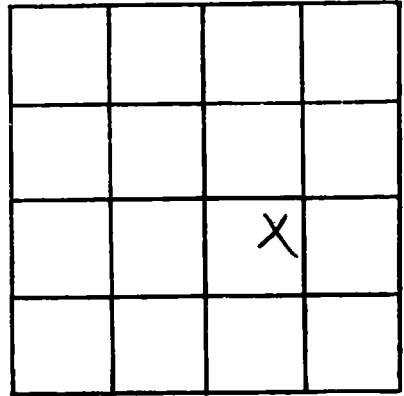

SECTION 25

Please indicate well location X.

ADDITIONAL INFORMATION

If more than one screen, show locations of each on sketch.