

Jackson  
 J 59  
 9-11-68

MISSISSIPPI  
 BOARD OF WATER COMMISSIONERS CODED  
 416 North State Street  
 Jackson, Mississippi 39201

WATER WELL DRILLERS LOG

Sept 11 1969 L.L. Garland Jackson  
 date well completed firm name county well located


LANDOWNER:	description of formations encountered	from	to
Leroy Wescovich Rt 1. Box 337A O.S. (mailing address)			
<b>WELL LOCATION:</b> sec 23 T 6 N R 9 E 24 miles west of Red. (distance) (direction) (nearest town)			
<b>WELL PURPOSE:</b> Home (home, irrigation, municipal, industrial)			
<b>WELL COMPLETION DATA:</b> (1) diameter (inches) 2" (2) total depth (feet) 504 (3) static water level (feet) 9 <sup>below</sup> / <sub>above</sub> top of ground. (4) casing <u>steel</u> , 494 (material) (depth) 2" if telescope see back. (size) (5) screen 10 ft., 494 (length) (depth to top) 2" bronze (size) (material) (6) pump Customer installed (HP) (yield gpm) own pump (type power) (7) electric log <u>no</u> (yes or no) (organization running log) (8) how well bottom plugged <u>w. valve</u>			
<b>DRILLERS REMARKS:</b> 42 ft. sand			

CODED

FEB 25 1970  
 MISS. BD. OF  
 WATER COM. STAMP

If well telescopes please sketch and show depths.

GROUND LEVEL

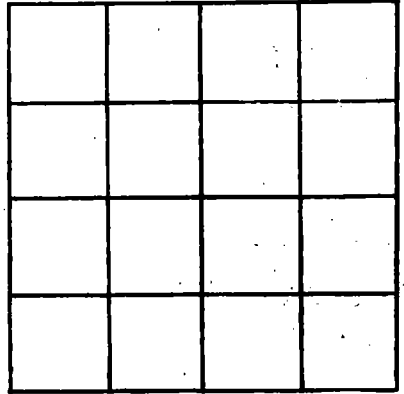

SECTION 23

Please indicate well location X.

ADDITIONAL INFORMATION

Lined area for additional information.

If more than one screen, show locations of each on sketch.