

CODED

MISSISSIPPI
BOARD OF WATER COMMISSIONERS
416 North State Street
Jackson, Mississippi 39201

WATER WELL DRILLERS LOG

Jackson
J 60
10-24-69

10-24 1969 date well completed
Coast Water Well Sew. firm name
Jackson county well located

LANDOWNER: John Comley
Vandover, Miss.
(mailing address)

description of formations encountered	from	to
Red clay	0	21
Sand fine - Med	21	167
Blue clay	167	325
Sand med - coarse	325	336
Blue clay	336	430
Sand Med - coarse	430	472

WELL LOCATION:
sec. 12 T 6 S R 8 W
3 miles west of Vandover
(distance) (direction) (nearest town)

WELL PURPOSE: Home
(home, irrigation, municipal, industrial)

- WELL COMPLETION DATA:
- (1) diameter (inches) 2
 - (2) total depth (feet) 470
 - (3) static water level (feet) 50 below top of ground
 - (4) casing galv. 460' (material) (depth)
2" (size) If telescope see back.
 - (5) screen 10' 460' (length) (depth to top)
2" Stainless Steel (size) (material)
 - (6) pump 1 (HP) 10 (yield gpm)
Elec. (type power)
 - (7) electric log NO (yes or no)
 - (organization running log)
 - (8) how well bottom plugged back - wash valve


DRILLERS REMARKS:

OCT 20

MISS. B.L. C. WATER COM.

If well telescopes please sketch and show depths.

GROUND LEVEL

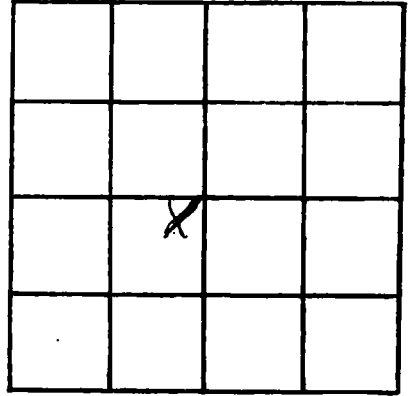

SECTION 12

Please indicate well location X.

ADDITIONAL INFORMATION

If more than one screen, show locations of each on sketch.