

CODED

CODED

MISSISSIPPI BOARD OF WATER COMMISSIONERS 416 North State Street Jackson, Mississippi 39201

WATER WELL DRILLERS LOG

Jackson  
8 62  
10-24-69

10/24/69 19 COASTAL DRILLING JACKSON  
date well completed firm name county well located

LANDOWNER: Mike S. Inman

Rt 3 Box 204 B

Box 1, Miss  
(mailing address)

WELL LOCATION:

sec 36 T 6 N R 9 E  
S W  
4 miles NE of Box 1  
(distance) (direction) (nearest town)

WELL PURPOSE: home  
(home, irrigation, municipal, industrial)

WELL COMPLETION DATA:

- (1) diameter (inches) 2"
- (2) total depth (feet) 400
- (3) static water level (feet) 18 below top of ground.
- (4) casing 2" (material), 400 (depth).  
(size) If telescope see back.
- (5) screen 10' (length), 390 (depth to top).  
2" (size), SS (material)
- (6) pump 1/2 (HP), 18 (yield gpm).  
ELe (type power)
- (7) electric log NO (yes or no)

(organization running log) BN

(8) how well bottom plugged  
Good

DRILLERS REMARKS:  
None


description of formations encountered	from	to
Top Soil	1	5
Red Clay	5	20
Water sand	20	45
Water Sand Course	45	60
Blue Clay	60	250
fine water sand	250	275
Whipshawl Clay C	275	300
White + Red Clay	300	360
Good Water Sand	360	400

JAN 12 1970

MISS. BD. OF WATER COMM.

If well telescopes please sketch and show depths.

GROUND LEVEL

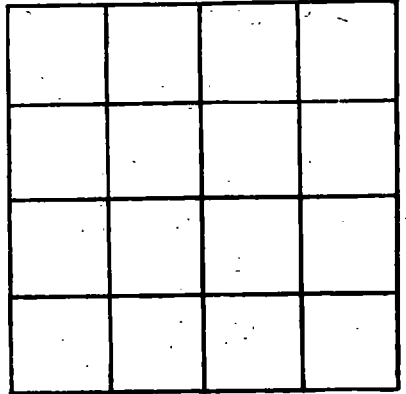

SECTION \_\_\_\_\_

Please indicate well location X.

ADDITIONAL INFORMATION

If more than one screen, show locations of each on sketch.