

Jackson
 J63
 12-15-69

MISSISSIPPI
 BOARD OF WATER COMMISSIONERS
 416 North State Street
 Jackson, Mississippi 39201

CODED
 CODED

WATER WELL DRILLERS LOG

12/15/69 19 Coastal Drilling Co. Jackson
 date well completed firm name county well located

LANDOWNER: Edward Lvery

Rt 2 Box 200A
 Ocean Springs, Miss
 (mailing address)

description of formations encountered	from	to
Blue + white Clay	1	15
White Sand	15	35
Grays	35	43
Hard Blue Clay	43	172
Very hard Red Clay	172	283
Fire water sand	283	300
Coarse water sand	300	320
Blue Clay	320	440
Fire water sand	440	465
Coarse water sand	465	505

WELL LOCATION:

sec. 11 T 6N R 9E
 One miles N Latimer
 (distance) (direction) (nearest town)

WELL PURPOSE: Home
 (home, irrigation, municipal, industrial)

WELL COMPLETION DATA:

- (1) diameter (inches) 2"
- (2) total depth (feet) 505
- (3) static water level (feet) 27 below top of ground
- (4) casing (material) gal (depth) 495
- (size) If telescope see back.
- (5) screen 10' 495 (length) (depth to top)
- 2" 33 (size) (material)
- (6) pump 1 1/4 HP 18 (HP) (yield gpm)
- Elec (type power)
- (7) electric log no (yes or no)

(organization running log)

(8) how well bottom plugged
 2" back wash valve


DRILLERS REMARKS:
 None

JAN 20 1970

MISS. BD. OF
 WATER COMM.

If well telescopes please sketch and show depths.

GROUND LEVEL

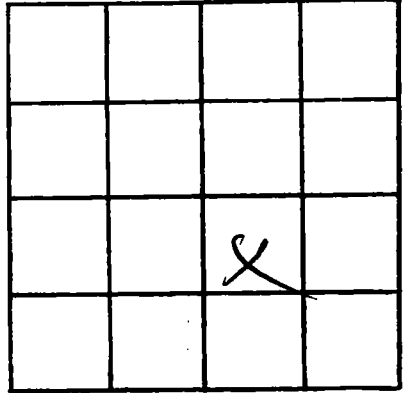

SECTION 11

Please indicate well location X.

ADDITIONAL INFORMATION

If more than one screen, show locations of each on sketch.