

Jackson  
 J 65  
 5-11-70  
 3

MISSISSIPPI  
 BOARD OF WATER COMMISSIONERS  
 416 North State Street  
 Jackson, Mississippi 39201

**CODED**

WATER WELL DRILLERS LOG

5/11/70 date well completed  
 Central Drilling Co. firm name  
 Jackson county well located

LANDOWNER: J. Thomas  
 Rt 3  
 Ocean Springs, Ala (mailing address)

description of formations encountered	from	to
Top Soil	1	6
Red Clay	6	18
White Sand	18	42
Blue Clay	42	122
fine water Sand	122	140
Hard Blue Clay	140	215
fine water Sand	215	225
Coarse white Sand	225	252

WELL LOCATION:  
 sec. 3 T. 6 N R. 9 E S. 1  
 (2) 7/10 miles N of Lakeview (distance) (direction) (nearest town)

WELL PURPOSE: home  
 (home, irrigation, municipal, industrial)

WELL COMPLETION DATA:  
 (1) diameter (inches) 2"  
 (2) total depth (feet) 252  
 (3) static water level (feet) 18 below top of ground.  
 (4) casing galv. 2 1/2" (material) (depth)  
 (size) If telescope see back.  
 (5) screen 10' 2 1/2" (length) (depth to top) (size) (material)  
 (6) pump 1 1/4 HP 19 (type power) (yield gpm)  
 (7) electric log no (yes or no)  
 (organization running log) no

(8) how well bottom plugged  
 2' traditional holes


DRILLERS REMARKS:  
 None

JUN 11 1970

MISS. BOARD OF WATER COMMISSIONERS

If well telescopes please sketch and show depths.

GROUND LEVEL

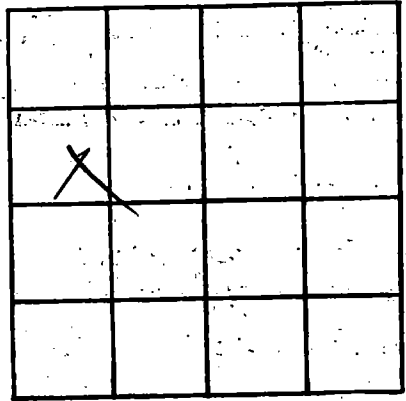

SECTION 3

Please indicate well location X.

ADDITIONAL INFORMATION

If more than one screen, show locations of each on sketch.