

Jackson
 J 66
 4-27-70

MISSISSIPPI
 BOARD OF WATER COMMISSIONERS
 416 North State Street
 Jackson, Mississippi 39201

CODED

WATER WELL DRILLERS LOG

#/27/70 19 date well completed
 Coastal Drilling Co. firm name
 Jackson county well located

LANDOWNER: DW Loney
RT 2
Ocean Spring Miss
 (mailing address)

description of formations encountered	from	to
Top Soil	1	10
White Sand	10	27
Red Sand	27	32
Clay Blue	32	37
White Sand	37	44
Blue clay	44	290
fine water sand	290	298
hard blue clay	298	328
fine water sand	328	350
Coarse water sand	350	392

WELL LOCATION:
 sec 4 T 6 S R 9 E 209
3 1/2 miles N of Biloxi
 (distance) (direction) (nearest town)

WELL PURPOSE: home
 (home, irrigation, municipal, industrial)

WELL COMPLETION DATA:

(1) diameter (inches) 2"

(2) total depth (feet) 392

(3) static water level (feet) 33 below top of ground.

(4) casing glue 382
 (material) (depth)
 (size) if telescope see back.

(5) screen 10' 382
 (length) (depth to top)
2" SS
 (size) (material)

(6) pump 1 HP 18
 (HP) (yield gpm)
5 hp
 (type power)

(7) electric log No
 (yes or no)

(organization running log)

(8) how well bottom plugged
2 feet with valve


DRILLERS REMARKS:
None

MAY 7 1970

MISS. DD. OF
 WATER 06PM

If well telescopes please sketch and show depths.

GROUND LEVEL

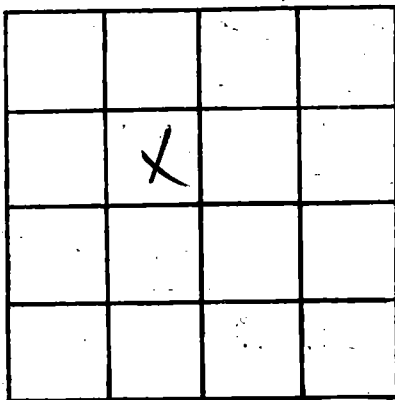

SECTION _____

Please indicate well location X.

ADDITIONAL INFORMATION

If more than one screen, show locations of each on sketch.