

Jackson
 J 71
 6-18-70

MISSISSIPPI
 BOARD OF WATER COMMISSIONERS
 416 North State Street
 Jackson, Mississippi 39201

CODED

WATER WELL DRILLERS LOG

6/18/70 19 Crestal Drilling Co. Jackson
 date well completed firm name county well located

LANDOWNER: Jim Harris
Rt 3 Box 210
Biloxi, Miss
 (mailing address)

WELL LOCATION:
 sec 23 T 6 N R 9 E
2.7 miles S of Farmers
 (distance) (direction) (nearest town)

WELL PURPOSE: home
 (home, irrigation, municipal, industrial)

WELL COMPLETION DATA:
 (1) diameter (inches) 2"
 (2) total depth (feet) 352
 (3) static water level (feet) 40 below above
 top of ground.
 (4) casing galv. 342
 (material) (depth)
 (size) if telescope see back.
 (5) screen 10' 342
 (length) (depth to top)
2" SS
 (size) (material)
 (6) pump 1 HP 12
 (HP) (yield gpm)
elec
 (type power)
 (7) electric log no
 (yes or no)
 (organization running log)

description of formations encountered	from	to
top soil	1	3
Coarse white sand	3	34
Blue clay	34	60
white sand	60	74
hard blue clay	74	156
fine water sand	156	120
Coarse water sand	120	125
hard blue clay	125	289
heavy comb	289	320
fine water sand	320	332
Coarse water sand	330	352

CODED


JUL 14 1970

MISS. BD. OF
 WATER COMM.

(8) how well bottom plugged
2" back wash valve
 DRILLERS REMARKS:
None

If well telescopes please sketch and show depths.

GROUND LEVEL

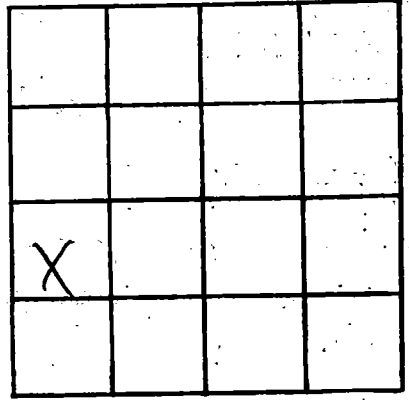

SECTION _____

Please indicate well location X.

ADDITIONAL INFORMATION

If more than one screen, show locations of each on sketch.