

JACKSON
J 73

10-11-70

MISSISSIPPI
BOARD OF WATER COMMISSIONERS
416 North State Street
Jackson, Mississippi 39201

CODED

WATER WELL DRILLERS LOG

10/11/70
date well completed

Coaster Valley Co.
firm name

Jackson
county well located

LANDOWNER: L. H. Seymour

Rt 3 Box 640

Biloxi, Miss.
(mailing address)

description of formations encountered	from	to
Top Soil	1	3
Red Sand	3	14
White Sand	14	39
fine water sand	39	60
fine blue clay	60	244
fine water sand	244	262
hard blue clay	262	400
fine water sand	400	415
fine water sand	415	444

WELL LOCATION:

sec. 27 T. 6 N. R. 8 E
S W
1/4 mi. S of
(distance) (direction) (nearest town)

WELL PURPOSE: home
(home, irrigation, municipal, industrial)

WELL COMPLETION DATA:

- (1) diameter (inches) 2"
- (2) total depth (feet) 444
- (3) static water level (feet) 30
top of ground.
- (4) casing glass 434
(material) (depth)
if telescope see back.
- (5) screen 10' 434
(length) (depth to top)
24 (size) 58 (material)
- (6) pump 1 HP 18
(HP) (yield gpm)
Eli (type power)
- (7) electric log no
(yes or no)
- (organization running log)

CODED

(8) boy, well bottom plugged
L. H. Seymour


NOV 17 1970

DRILLERS REMARKS:
None

MISS. BD. OF
WATER COMM.

If well telescopes please sketch and show depths.

GROUND LEVEL

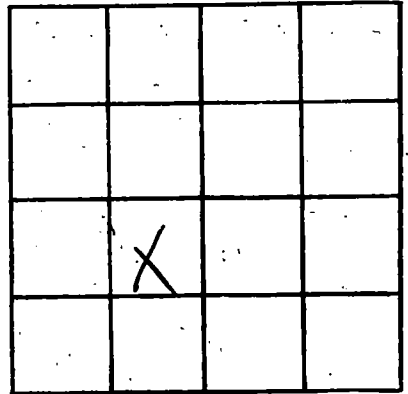

SECTION _____

Please indicate well location X.

ADDITIONAL INFORMATION

If more than one screen, show locations of each on sketch.