

JACKSON

J 74

10-13-70

MISSISSIPPI BOARD OF WATER COMMISSIONERS 416 North State Street Jackson, Mississippi 39201

CODED

WATER WELL DRILLERS LOG

10/13/70 date well completed

Coastal Drilling Co. Jackson firm name

county well located

LANDOWNER

333 Barnes St

N. Bilal, Jr. in (mailing address)

WELL LOCATION:

sec. 24 T. 6 N. R. 8 E S. W

United Gas Lines (distance) (direction) (nearest town)

WELL PURPOSE:

(home, irrigation, municipal, industrial)

WELL COMPLETION DATA:

- (1) diameter (inches) 2"
(2) total depth (feet) 434
(3) static water level (feet) 27 below above top of ground
(4) casing (material) (depth)
(5) screen (length) (depth to top)
(6) pump (type) (yield gpm)
(7) electric log (yes or no)

description of formations encountered

Table with 3 columns: description of formations encountered, from, to. Rows include top soil, Red Sand, white Sand, fine water Sand, coarse water Sand, hard yellow clay, fine water Sand, coarse water Sand.

CODED

(8) how well bottom plugged

2' horizontal water

DRILLERS REMARKS:


None

NOV 17 1970

MISS. BD. OF WATER COMM.

If well telescopes please sketch and show depths.

GROUND LEVEL

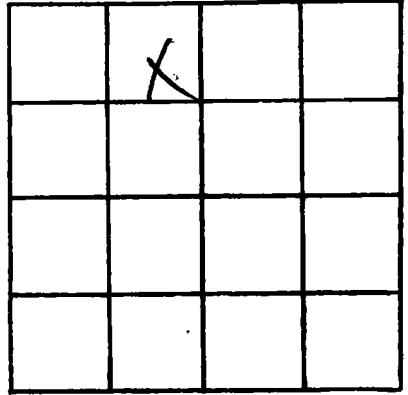

SECTION \_\_\_\_\_

Please indicate well location X.

ADDITIONAL INFORMATION

If more than one screen, show locations of each on sketch.