

JACKSON

MISSISSIPPI BOARD OF WATER COMMISSIONERS

J 77

8-8-60

WATER WELL DRILLERS LOG

3944

CODED

Date: Aug 8, 1960, Driller: L.L. Garland County Jackson (Name)

(1) Owner of Land: E.M. Allister  
 (Name)  
Rt. #1 Ocean Springs  
 (Address)

(2) Location:  $\frac{1}{4}$ ,  $\frac{1}{4}$ , Sec. 14 T 6 R 8  
12 miles East of O.S.  
 (distance) (direction) (Nearest Town)

(3) Topography: Hilly  
 (Hilly) (Flat) (Level)

(4) Purpose of Well: Domestic  
 (Domestic Irrigation  
 Municipal, Industrial, Other)

Description & Color of Materials Sand, Clay, Red Clay, Shell, etc.	Thick- ness Feet	Depth Feet
Red Clay	21	
Sand	63	
Blue Clay	42	
Sand	42	
Sand & Clay	21	
Blue Clay	39	
Sand	3	
Blue Clay	39	
Hard Shale	42	
Blue Clay (Hard)	21	
Shale	18	
Sand (Fine)	68	
" (Coarse)	31	

Information upon completion of well:

(1) Diameter 2" inches.

(2) Total Depth 451' feet.

(3) Water Level 41' feet below top of ground.

(4) Cased to \_\_\_\_\_, Size \_\_\_\_\_

(5) Screen: Size 2"-08 Length 10'


(6) Were any formations sealed against pollution?  
 \_\_\_\_\_ yes, \_\_\_\_\_ no.

If YES depth of formation \_\_\_\_\_

Why \_\_\_\_\_

Drillers Remarks: \_\_\_\_\_

CODED

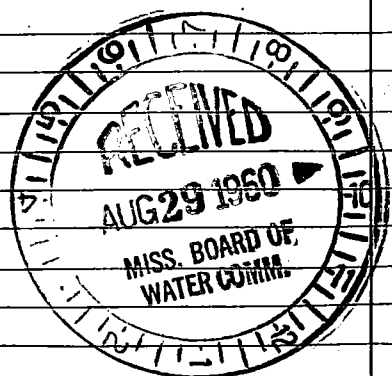

(Use Back Side)

Well No.

