

JACKSON

MISSISSIPPI BOARD OF WATER COMMISSIONERS

can't locate

J 82  
9-26-63

WATER WELL DRILLERS LOG

3956

CODED

Date: 9/26, 1963, Driller: Arthur Butner County Jackson  
(Name)

(1) Owner of Land: Fred Seymour  
(Name)  
Vanclave, Miss  
(Address)  
26 6 8

(2) Location: 1/4, 1/4, Sec. T R  
Fort Payne Rd - across from  
Antioch Baptist Church  
(distance) (direction) (Nearest Town)

(3) Topography: Flat  
(Hilly) (Flat) (Level)

(4) Purpose of Well: Domestic  
(Domestic Irrigation  
Municipal, Industrial, Other)

Description & Color of Materials Sand, Clay, Red Clay, Shell, etc.	Thick- ness Feet	Depth Feet
<u>Red Sand</u>	<u>0</u>	<u>12</u>
<u>White Clay</u>	<u>12</u>	<u>18</u>
<u>Red Clay</u>	<u>18</u>	<u>40</u>
<u>White Sand</u>	<u>40</u>	<u>50</u>
<u>Blue Clay</u>	<u>50</u>	<u>120</u>
<u>Blue Sand</u>	<u>120</u>	<u>160</u>

CODED

Information upon completion of well:

(1) Diameter 2 inches.

(2) Total Depth 160 feet.

(3) Water Level 14 feet below top of ground.

(4) Cased to \_\_\_\_\_, Size \_\_\_\_\_.


(5) Screen: Size 2", Length 10'.

(6) Were any formations sealed against pollution?  
\_\_\_\_\_ yes, \_\_\_\_\_ no.

If YES depth of formation \_\_\_\_\_

Why \_\_\_\_\_

Drillers Remarks: \_\_\_\_\_

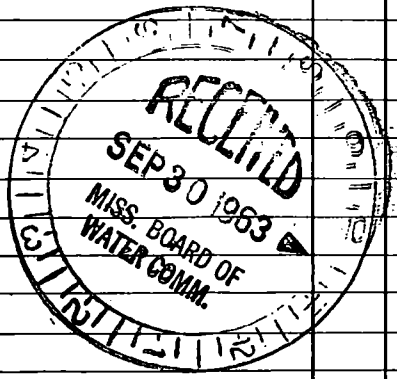

Well No.

(Use Back Side)

