

JACKSON

MISSISSIPPI BOARD OF WATER COMMISSIONERS

584

WATER WELL DRILLERS LOG

CODED

4-27-65 2881

Date: 4-27, 1965, Driller: C. T. Surtzger Well Co. County Jackson

(Name)

(1) Owner of Land: Floyd Ely  
3 blocks N. Comp M. Chiles  
Rd on 2d road East of  
 (Address) Suckers Pond

(2) Location: 1/4, 1/4, Sec. 35 T. 6 R. 9,  
 (distance) (direction) (Nearest Town)

(3) Topography: \_\_\_\_\_  
 (Hilly) (Flat) (Level)

(4) Purpose of Well: Domestic  
 (Domestic Irrigation  
 Municipal, Industrial, Other)

Description & Color of Materials Sand, Clay, Red Clay, Shell, etc.	Thick- ness Feet	Depth Feet
Clay	0	21
Clay + few sand strucks	21	42
Clay	42	63
Clay + few sand sth	63	84
Clay	84	158
Sand fine	158	168
Clay	168	179
Sand, real fine	179	218
Clay	218	252
Sand + clay strucks	252	273
Clay	273	300
Sand, good	300	388

Information upon completion of well:

(1) Diameter 2 inches.

(2) Total Depth 388 feet.

(3) Water Level 27' feet below top of ground.

(4) Cased to 388', Size 2"

(5) Screen: Size 2", Length 10'


(6) Were any formations sealed against pollution?  
 yes, \_\_\_\_\_ no.

If YES depth of formation \_\_\_\_\_

Why Health Dept. Requirement

Drillers Remarks: \_\_\_\_\_

CODED

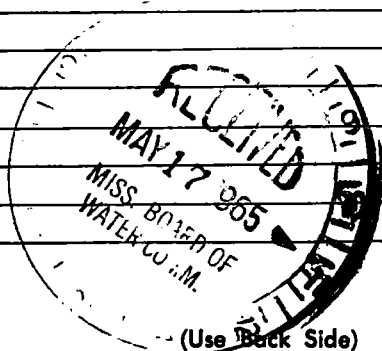

Well No.

