

JACKSON MISSISSIPPI BOARD OF WATER COMMISSIONERS

J585

11-12-65 3953

WATER WELL DRILLERS LOG

CODED

Date: 11-12, 1965, Driller: Hattiesburg Butlers County (Name)

(1) Owner of Land: D. V. Hatten
(Name)
Olean Springs
(Address)

(2) Location: $\frac{1}{4}$, $\frac{1}{4}$, Sec. 24 6 8 R
Foot Bayou Rd.
(distance) (direction) (Nearest Town)

(3) Topography: X
(Hilly) (Flat) (Level)

(4) Purpose of Well: domestic
(Domestic Irrigation Municipal, Industrial, Other)

Description & Color of Materials Sand, Clay, Red Clay, Shell, etc.	Thick- ness Feet	Depth Feet
yellow clay	0-	18
yellow sand	18-	22
yellow clay	22-	28
Blue clay	28-	55
yellow clay	55-	72
Blue clay	72-	120
Blue sand	120-	170
Blue clay	170-	240
Blue sand	240-	274
Blue clay	274-	310
Blue sand	310-	380

Information upon completion of well:

(1) Diameter 2 inches.

(2) Total Depth 380 feet.

(3) Water Level 33 feet below top of ground.

(4) Cased to _____, Size _____

(5) Screen: Size 2", Length 10'


(6) Were any formations sealed against pollution?
 _____ yes, X no.

CODED

If YES depth of formation _____

Why _____

Drillers Remarks: _____

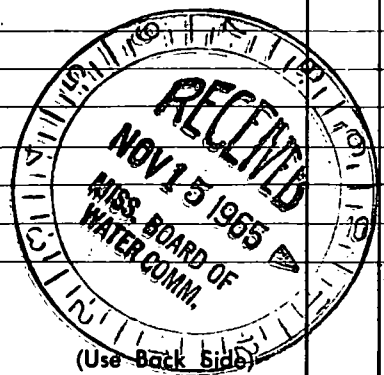

Well No.

