

JACKSON
 587
 4-23-71

MISSISSIPPI
 BOARD OF WATER COMMISSIONERS
 416 North State Street
 Jackson, Mississippi 39201
 WATER WELL DRILLERS LOG

CODED

4-23 1971 date well completed
 21 Coast Water Well Service firm name
 Jackson County well located

LANDOWNER:	description of formations encountered	from	to
Gene Jennings Rt. 2	top soil & clay	0	20
Ocean Springs, Miss. (mailing address)	sand - med to coarse	20	78
WELL LOCATION: sec. 26T 6R S R 8 5 miles SW of Ocean (distance) (direction) (nearest town)	blue clay	78	120
	sand - fine to med.	120	183
	blue clay	183	307
WELL PURPOSE: (home, irrigation, municipal, industrial)	sand - med. to coarse	307	357

WELL COMPLETION DATA:

(1) diameter (inches) 2"

(2) total depth (feet) 357

(3) static water level (feet) 45 below above top of ground.

(4) casing galv. 347'
 (material) (depth)
2" if telescope see back.
 (size)

(5) screen 10' 347'
 (length) (depth to top)
2" stainless borlug
 (size) (material)

(6) pump 1 12
 (HP) (yield gpm)
elec.
 (type power)

(7) electric log no
 (yes or no)

(organization running log)

(8) how well bottom plugged
packed with stone

CODED


MAY 5 - 1971

MISS. BD. OF
 WATER COMM.

DRILLERS REMARKS:

If well telescopes please sketch and show depths.

GROUND LEVEL

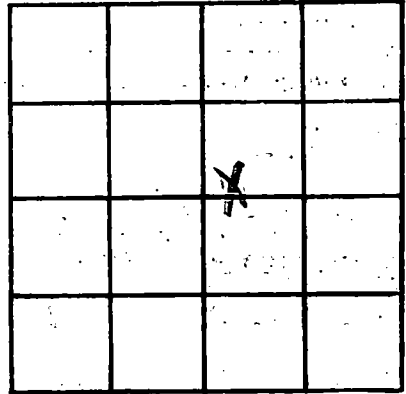

SECTION 26

Please indicate well location X.

ADDITIONAL INFORMATION

If more than one screen, show locations of each on sketch.