

MISSISSIPPI  
BOARD OF WATER COMMISSIONERS  
416 North State Street  
Jackson, Mississippi 39201

**CODED**

**WATER WELL DRILLERS LOG**

JACKSON  
JBB  
5-2-71

5-2-71 19  
date well completed

R. J. Moore  
firm name

JACKSON  
county well located

LANDOWNER: Lum McWilliams

description of formations encountered

from

to

Rt 1 Box 371 K

OCEAN SPRINGS, MISS  
(mailing address)

WELL LOCATION:

sec. 31 T. 6 N. R. 9 E.  
7 miles N of ST MARTIN  
(distance) (direction) (nearest town)

WELL PURPOSE:

(home irrigation, municipal, industrial)

WELL COMPLETION DATA:

(1) diameter (inches) 2"  
(2) total depth (feet) 336'  
(3) static water level (feet) 38' <sup>below</sup> <sub>above</sub> top of ground.

(4) casing 2 1/2" 325'  
(material) (depth)

(size) if telescope see back.

(5) screen 2x20 315'  
(length) (depth to top)

2" SS  
(size) (material)

(6) pump 1 12  
(HP) (yield gpm)

E  
(type power)

(7) electric log \_\_\_\_\_  
(yes or no)

(organization running log)

(8) how well bottom plugged By  
Water

| description of formations encountered | from | to  |
|---------------------------------------|------|-----|
| TOP SOIL                              | 0    | 10  |
| Blue Clay                             | 10   | 83  |
| SILT Sand                             | 83   | 90  |
| Blue Clay                             | 90   | 167 |
| Blue Sand                             | 167  | 188 |
| Blue Clay                             | 188  | 314 |
| Coarse Blue Sand                      | 314  | 336 |

**CODED**


MAY 5 - 1971

MISS. BD. OF  
WATER COM.

DRILLERS REMARKS:

If well telescopes please sketch and show depths.

GROUND LEVEL

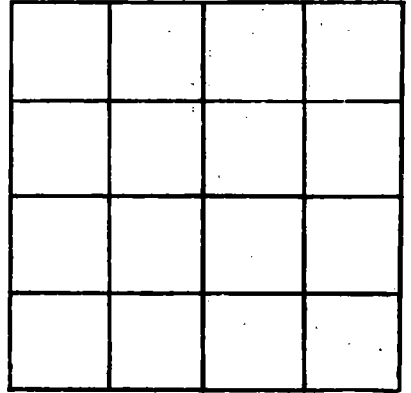

SECTION \_\_\_\_\_

Please indicate well location X.

ADDITIONAL INFORMATION

If more than one screen, show locations of each on sketch.