

JACKSON
JB9
5-4-71

MISSISSIPPI
BOARD OF WATER COMMISSIONERS
416 North State Street
Jackson, Mississippi 39201

CODED

WATER WELL DRILLERS LOG

may 4 1971 L.L. Garland Water Wells Jackson
date well completed firm name county well located

LANDOWNER: Howard Glass, Sr.
120 Sunbeam Drive
Ocean Springs, Miss
(mailing address)

description of formations encountered from to

WELL LOCATION:
sec. 4 T. 6 N. R. 8 E
8 miles north of O.S.
(distance) (direction) (nearest town)

WELL PURPOSE: home
(home, irrigation, municipal, industrial)

WELL COMPLETION DATA:

- (1) diameter (inches) 2
- (2) total depth (feet) 483
- (3) static water level (feet) 46 ^{below} _{above} top of ground.
- (4) casing steel, 473,
(material) (depth)
_____ if telescope see back.
(size)
- (5) screen 10, 473
(length) (depth to top)
2", st. steel
(size) (material)
- (6) pump 1/2, 400 gal per hr.
(HP) (yield/gpm)
electric
(type power)
- (7) electric log _____
(yes or no)

(organization running log)
- (8) how well bottom plugged back wash valve

CODED


MAY 14 1971

MISS. BD. OF
WATER COMM.

DRILLERS REMARKS:
32 ft. water
bearing sand

If well telescopes please sketch and show depths.

GROUND LEVEL

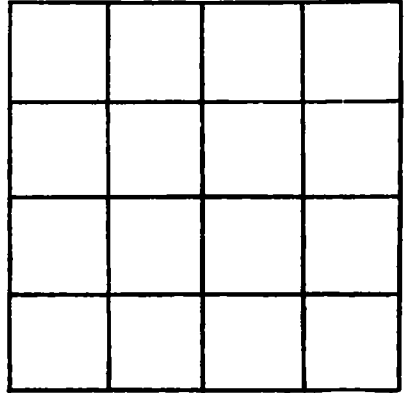

SECTION _____

Please indicate well location X.

ADDITIONAL INFORMATION

Lined area for additional information, consisting of 18 horizontal lines.

If more than one screen, show locations of each on sketch.