

MISSISSIPPI
BOARD OF WATER COMMISSIONERS
416 North State Street
Jackson, Mississippi 39201

WATER WELL DRILLERS LOG

JACKSON
J-91
6-30-71

Jackson
CODED

6/30/71 19 Central Drilling Co. firm name
Date well completed county well located

LANDOWNER: C.V. Olson
RT 2 Box 352
Ocean Spring Miss
(mailing address)

description of formations encountered	from	to
<u>Top Soil</u>	<u>1</u>	<u>3</u>
<u>Red Clay</u>	<u>3</u>	<u>18</u>
<u>Shale</u>	<u>18</u>	<u>35</u>
<u>Red Clay</u>	<u>35</u>	<u>47</u>
<u>Blue Clay</u>	<u>47</u>	<u>325</u>
<u>Fire water sand</u>	<u>325</u>	<u>370</u>
<u>Coarse sand</u>	<u>370</u>	<u>408</u>

WELL LOCATION:
sec 24 T 6N R 8E
S W
6 7/8 miles NW Ocean Spring
(distance) (direction) (nearest town)

WELL PURPOSE: home
(home, irrigation, municipal, industrial)

WELL COMPLETION DATA:

(1) diameter (inches) 2"

(2) total depth (feet) 408

(3) static water level (feet) 40 below above
top of ground

(4) casing Steel
(material) (depth)

(size) If telescope see back.

(5) screen 10' 398
(length) (depth to top)

2" S.S.
(size) (material)

(6) pump One 16
(HP) (yield gpm)

Ele
(type power)

(7) electric log No
(yes or no)

(organization running log)

CODED

(8) how well bottom plugged 2"
black wash water


DRILLERS REMARKS:
None

SEP 15 1971

MISS. BD. OF
WATER COM.

If well telescopes please sketch and show depths.

GROUND LEVEL

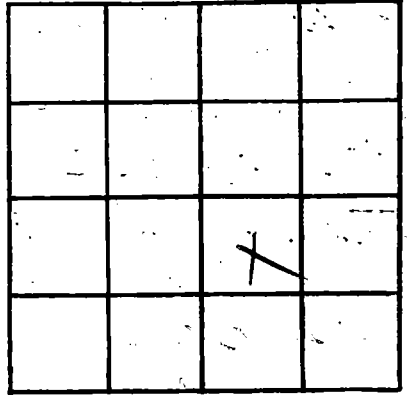

SECTION _____

Please indicate well location X.

ADDITIONAL INFORMATION

If more than one screen, show locations of each on sketch.