

JACKSON
 J105
 10-4-72

MISSISSIPPI
 BOARD OF WATER COMMISSIONERS
 416 North State Street
 Jackson, Mississippi 39201

WATER WELL DRILLERS LOG

10-4 1972 Switzer Well Company Jackson
 date well completed firm name county well located

LANDOWNER: Bobby Hubbard Rt 1 Box 197K Ocean Springs, Miss 39564 (mailing address)	description of formations encountered	from	to
	Clay	0	18
	Sand	18	23
	Clay	23	44
	Clay-sand str.	44	65
	Clay	65	151
	Clay-sand str.	151	172
	sand	172	197
WELL LOCATION: sec. 15 T. 6 S R. 9 W 6 miles N of Biloxi (distance) (direction) (nearest town)			
WELL PURPOSE: HOME (home, irrigation, municipal, industrial)			
WELL COMPLETION DATA: (1) diameter (inches) 2" (2) total depth (feet) 197' (3) static water level (feet) 29' below top of ground. (4) casing galv. 197' (material) (depth) (size) If telescope see back. (5) screen 10' 187' (length) (depth to top) 008 stainless steel (size) (material) (6) pump 1 10 (HP) (yield gpm) ELECTRIC (type power) (7) electric log no (yes or no) (organization running log) (8) how well bottom plugged back pressure valve			


COPIED

OCT 27 1972

DRILLERS REMARKS:

If well telescopes please sketch and show depths.

GROUND LEVEL

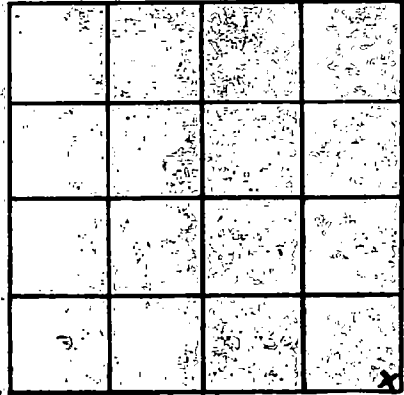

SECTION 15

Please indicate well location X.

ADDITIONAL INFORMATION

If more than one screen, show locations of each on sketch.