

JACKSON  
 J 107  
 11-1-72

MISSISSIPPI  
 BOARD OF WATER COMMISSIONERS  
 416 North State Street  
 Jackson, Mississippi 39201  
 WATER WELL DRILLERS LOG

11-1 1972 Switzer Well Company Jackson  
 date well completed firm name county well located

LANDOWNER: <u>Charles Hilton</u>	description of formations encountered	from	to
<u>Castright Lane</u>			
<u>Biloxi, Miss.</u>	clay	0	15
(mailing address)	sand	15	34
WELL LOCATION:	clay	34	40
sec. <u>34</u> T. <u>6</u> S. R. <u>9</u> W.	mixed	40	60
<u>3 1/4</u> miles <u>N</u> of <u>Biloxi</u>	clay	60	176
(distance) (direction) (nearest town)	sand	176	189
WELL PURPOSE: <u>Home</u>			
(home, irrigation, municipal, industrial)			
WELL COMPLETION DATA:			
(1) diameter (inches) <u>2"</u>			
(2) total depth (feet) <u>189'</u>			
(3) static water level (feet) <u>41'</u> <u>below</u> top of ground.			
(4) casing <u>galv.</u> <u>189'</u> (material) (depth)			
(size) If telescope see back.			
(5) screen <u>10'</u> <u>179'</u> (length) (depth to top)			
<u>006</u> <u>Stainless Steel</u> (size) (material)			
(6) pump <u>1</u> <u>10</u> (HP) (yield gpm)			
<u>Electric</u> (type power)			
(7) electric log <u>No</u> (yes or no)			
(organization running log)			
(8) how well bottom plugged <u>back</u> <u>pressure valve</u>			


NOV 30 1972

WATER COMMISSIONERS

DRILLERS REMARKS:

If well telescopes please sketch and show depths.

GROUND LEVEL

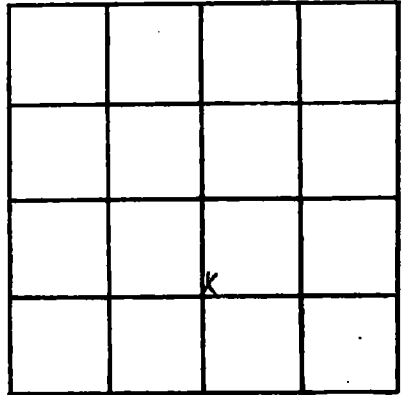

SECTION 34

Please indicate well location X.

ADDITIONAL INFORMATION

If more than one screen, show locations of each on sketch.