

JACKSON

J 108

11-10-72

MISSISSIPPI BOARD OF WATER COMMISSIONERS

416 North State Street

Jackson, Mississippi 39201

WATER WELL DRILLERS LOG

11-10 1972 date well completed

Switzer Well Co. firm name

Jackson county well located

LANDOWNER:	description of formations encountered	from	to
Charles L. Hutson	Clay	0	20
961	Sand	20	35
Ocean Springs, Miss. (mailing address)	Clay	35	60
	Mixed	60	70
WELL LOCATION:	Clay	70	117
sec. 25 T. 6 S. R. 9 W.	Sand	117	120
5 1/2 miles N of Ocean Springs (distance) (direction) (nearest town)	Mixed	120	130
	Clay	130	224
WELL PURPOSE: Home (home, irrigation, municipal, industrial)	Sand	224	232
	Clay	232	298
WELL COMPLETION DATA:	Mixed	298	308
(1) diameter (inches) 2"	Clay	308	338
(2) total depth (feet) 436'	Shell	338	357
(3) static water level (feet) 46' 7" below top of ground	Clay + shell	357	377
(4) casing galv. 436' (material) (depth)	Clay	377	414
(size) If telescope see back.	Sand	414	435
(5) screen 10' 426' (length) (depth to top)			
008 Stainless Steel (size) (material)			
(6) pump 1 (HP) 10 (yield gpm)			
Electric (type power)			
(7) electric log no (yes or no)			
(organization running log)			
(8) how well bottom plugged back Pressure Valve			


NOV 30 1972

DRILLERS REMARKS:

Miss. Bd. of WATER COMM.

If well telescopes please sketch and show depths.

GROUND LEVEL

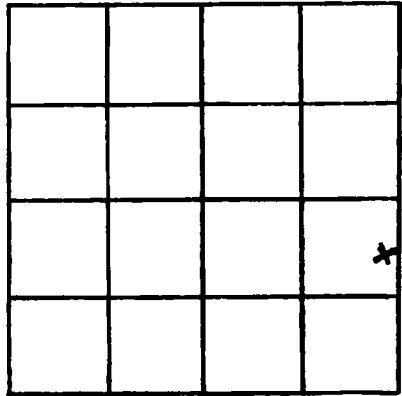

SECTION 25

Please indicate well location X.

ADDITIONAL INFORMATION

Multiple horizontal lines for writing additional information.

If more than one screen, show locations of each on sketch.