

JACKSON  
 JT 110  
 12-5-72

MISSISSIPPI  
 BOARD OF WATER COMMISSIONERS  
 416 North State Street  
 Jackson, Mississippi 39201  
 WATER WELL DRILLER

CODED

12-5-1972 date well completed  
 Switzer Well Co. firm name  
 Jackson county well located

LANDOWNER: John Conant Co.  
 (for Ouelain John)  
 Kaehn Rd.  
 Biloxi, Miss. 39522  
 (mailing address)

WELL LOCATION:  
 sec. 14 T. 6 S. R. 9 W.  
6 miles N of Biloxi  
 (distance) (direction) (nearest town)

WELL PURPOSE: home  
 (home, irrigation, municipal, industrial)

WELL COMPLETION DATA:

- (1) diameter (inches) 2"
- (2) total depth (feet) 457'
- (3) static water level (feet) 21 below  
above  
top of ground.
- (4) casing galv. 457'  
(material) (depth)  
         If telescope see back.  
(size)
- (5) screen 10' 447'  
(length) (depth to top)  
008 stainless steel  
(size) (material)
- (6) pump 1/2 day used 6'  
(HP) (yield gpm)  
ELECT  
(type power)
- (7) electric log no  
(yes or no)  
          
(organization running log)
- (8) how well bottom plugged back  
pressure valve

description of formations encountered	from	to
	c	129
clay		129
clay-sand str	129	150
clay	150	175
sand	175	178
clay	178	219
sand-str	219	237
clay	237	264
sand, fine	264	273
clay	273	279
clay-sand str.	279	300
clay	300	348
sand, fine	348	354
clay	354	364
clay-shale	364	407
clay	407	423
sand, fine	423	428
sand	428	457


CODED

DEC 26 1972

DRILLERS REMARKS:

If well telescopes please sketch and show depths.

GROUND LEVEL

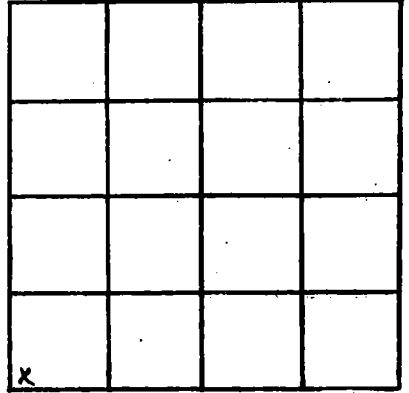

SECTION 14

Please indicate well location X.

ADDITIONAL INFORMATION

If more than one screen, show locations of each on sketch.