

JACKSON

J 118

5-31-73

MISSISSIPPI
 BOARD OF WATER COMMISSIONERS
 416 North State Street
 Jackson, Mississippi 39201

CODED

WATER WELL DRILLERS LOG

5-31 1973 Switzer Well Co. Jackson
 date well completed firm name county well located

LANDOWNER Edward Wright

Rt 2 Bx 334

Ocean Springs, Miss.
 (mailing address)

WELL LOCATION:

sec 11 T 6 S R 8 W
9 miles N of Ocean Springs
 (distance) (direction) (nearest town)

WELL PURPOSE: home
 (home, irrigation, municipal, industrial)

WELL COMPLETION DATA:

- (1) diameter (inches) 2"
- (2) total depth (feet) 505'
- (3) static water level (feet) 65' ^{below}/_{above} top of ground.
- (4) casing galv. 505'
 (material) (depth)

_____ If telescope see back.
 (size)

- (5) screen 10' 495'
 (length) (depth to top)

108 stainless steel
 (size) (material)

- (6) pump 1 jet 9.5
 (HP) (yield gpm)

electric
 (type power)

- (7) electric log no
 (yes or no)

_____ (organization running log)

- (8) how well bottom plugged back
pressure valve

description of formations encountered	from	to
clay	0	20
mixed	20	60
sand	60	75
mixed	75	80
stnd - clay	80	120
fine sand - red	120	140
sand - gravel	140	180
clay	180	317
sand	317	319
clay	319	359
clay - shale	359	379
clay	379	433
sand	433	438
stnd, fair	438	458
stnd, good	458	498

CODED


JUN 29 1973

DRILLERS REMARKS:

MISS. BD. OF
 WATER COMMISSIONERS

If well telescopes please
sketch and show depths.

GROUND LEVEL

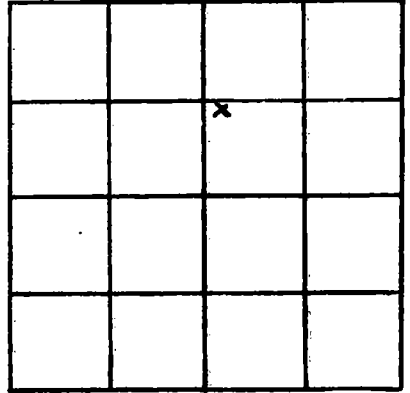

SECTION 11

Please indicate well location X.

ADDITIONAL INFORMATION

If more than one screen,
show locations of each on sketch.