

JACKSON
~~3169~~J123
 5-11-73

MISSISSIPPI
 BOARD OF WATER COMMISSIONERS
 416 North State Street
 Jackson, Mississippi 39201

CODED

WATER WELL DRILLERS LOG
 COASTAL DRILLING & SERVICE CO.

Jackson
 county well located

5/11/73
 date well completed

ROUTE 1 Biloxi, Miss.

LANDOWNER *Carl E. Cole*, BILOXI, MISS.

description of formations encountered	from	to
Top Soil	1	3
White Sand	3	14
Glauca	14	38
Blue sand	38	45
Super Sand	45	120
Soft Blue Clay	120	220
fine water sand	220	245
hard blue clay	245	365
fine water sand	365	400
Coarse water Sand	400	440

Coppage Rt 3
Biloxi, Miss
 (mailing address)

WELL LOCATION:
 sec *31 T 6 S R 2 E*
3 1/2 miles North, *3 1/2* miles West
 (distance) (direction) (nearest town)

WELL PURPOSE: *home*
 (home, irrigation, municipal, industrial)

WELL COMPLETION DATA:
 (1) diameter (inches) *4 1/2"*
 (2) total depth (feet) *440*
 (3) static water level (feet) *31* below above top of ground.
 (4) casing *galv*, *425'*
 (material) (depth)
4 1/2" If telescope see back.
 (size)
 (5) screen *15'*, *425'*
 (length) (depth to top)
2", *S.S.*
 (size) (material)
 (6) pump *One*, *20*
 (HP) (yield gpm)
Ele
 (type power)
 (7) electric log *No*
 (yes or no)
 (organization running log)

CODED

(8) how well bottom plugged
2" hard wood pipe

DRILLERS REMARKS:
Very good Well

SEP 7 1973

If well telescopes please sketch and show depths.

GROUND LEVEL


147' 4" galv Casing

278' 2" galv Casing

15' 2" S.S. Screen

2" hashrash hole

If more than one screen,
show locations of each on sketch.

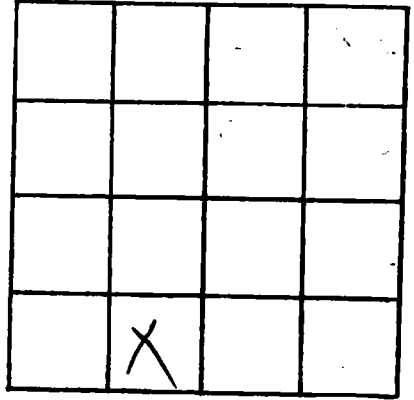

SECTION _____

Please indicate well location X.

ADDITIONAL INFORMATION

Lined area for additional information.