

JACKSON
J125
7-21-73

MISSISSIPPI
BOARD OF WATER COMMISSIONERS
416 North State Street
Jackson, Mississippi 39201

CODED

WATER WELL DRILLERS LOG

7/21 1973 COASTAL DRILLING & SERVICE CO. *Jackson*
date well completed firm name county well located
ROUTE 1 BOX 618

LANDOWNER: *SL. Hyde* BROOK, MISS. 39537

RT 1

Biloxi, Miss
(mailing address)

WELL LOCATION:

sec *23T* *6* R-*9*
11 miles *S* *South* of *Latimer*
(distance) (direction) (nearest town)

WELL PURPOSE: *Home*
(home, irrigation, municipal, industrial)

WELL COMPLETION DATA:

- (1) diameter (inches) *2"*
- (2) total depth (feet) *660'*
- (3) static water level (feet) *11'* below top of ground
- (4) casing *glad*, *650'*
(material) (depth)
- (5) screen *10'*, *650'*
(length) (depth to top)
2", *S.S.*
(size) (material)
- (6) pump *1/2*, *18*
(HP) (yield gpm)
Ele
(type power)
- (7) electric log *no*
(yes or no)

(organization running log)

(8) how well bottom plugged *2" black wash water*

DRILLERS REMARKS: *none*

description of formations encountered	from	to
<i>Top Soil</i>	<i>1</i>	<i>3</i>
<i>Red Clay</i>	<i>3</i>	<i>12</i>
<i>White Sand</i>	<i>12</i>	<i>40</i>
<i>Soft Blue Clay</i>	<i>40</i>	<i>200</i>
<i>fine water sand</i>	<i>200</i>	<i>210</i>
<i>Hard Blue sand</i>	<i>210</i>	<i>420</i>
<i>fine water sand</i>	<i>420</i>	<i>435</i>
<i>Rock</i>	<i>435</i>	<i>436</i>
<i>Hard Blue Band</i>	<i>436</i>	<i>590</i>
<i>fine water sand</i>	<i>590</i>	<i>605</i>
<i>Coarse water sand</i>	<i>605</i>	<i>660</i>


CODED

SEP 7 1973

MISS. STATE
WATER COMM.

If well telescopes please sketch and show depths.

GROUND LEVEL

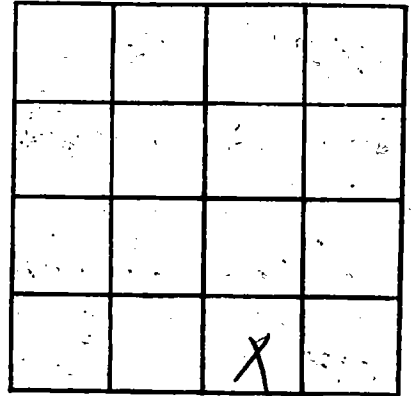

SECTION _____

Please indicate well location X.

ADDITIONAL INFORMATION

If more than one screen, show locations of each on sketch.