

JACKSON
 J129
 10-12-73

MISSISSIPPI
 BOARD OF WATER COMMISSIONERS
 416 North State Street
 Jackson, Mississippi 39201

WATER WELL DRILLERS LOG CODED

October 12, 1973 GARLAND WATER WELLS JACKSON
 date well completed firm name county well located

LANDOWNER: LOUISE PAGE
 1400 BIENVILLE Blvd.
 OCEAN SPRINGS, Miss
 (mailing address)

WELL LOCATION:
 sec. 24 T. 6 R. 9
 5 miles North of D/S
 (distance) (direction) (nearest town)

WELL PURPOSE: HOME
 (home, irrigation, municipal, industrial)


- WELL COMPLETION DATA:
- (1) diameter (inches) 2"
 - (2) total depth (feet) 220'
 - (3) static water level (feet) 15' below above top of ground.
 - (4) casing GALVANIZE PIPE 210'
 (material) (depth)
2" If telescope see back.
 (size)
 - (5) screen 10' 220' to 210'
 (length) (depth to top)
2" STAINLESS STEEL
 (size) (material)
 - (6) pump 1/2 8
 (HP) (yield gpm)
ELECTRIC
 (type power)
 - (7) electric log No
 (yes or no)
N/A
 (organization running log)
 - (8) how well bottom plugged PLASTIC
FLOAT BALL

description of formations encountered	from	to
TOP SOIL	0	15
FINE SAND	15	30
BLUE CLAY	30	60
MED SAND	60	80
BLUE CLAY	80	140
FINE SAND	140	160
BLUE CLAY	160	190
COURSE SAND	190	220

DRILLERS REMARKS:

If well telescopes please sketch and show depths.

GROUND LEVEL

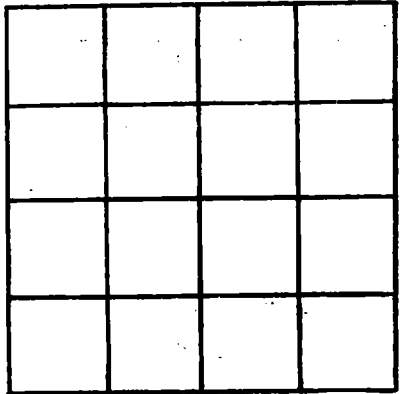

SECTION _____

Please indicate well location X.

ADDITIONAL INFORMATION

If more than one screen, show locations of each on sketch.