

JACKSON
J 130
3-3-74

MISSISSIPPI
BOARD OF WATER COMMISSIONERS
416 North State Street
Jackson, Mississippi 39201

WATER WELL DRILLERS LOG

JACKSON
~~HARRISON~~
county well located

3-3-74 19
date well completed

R.V. Moore
firm name

LANDOWNER: R.V. Domingues
RT 3 Box 421A
Bilochi, Miss
(mailing address)

WELL LOCATION:
sec. 34 T 6 N R 9 E
6 miles N of Ocean Springs
(distance) (direction) (nearest town)

WELL PURPOSE:
(home, irrigation, municipal, industrial)

WELL COMPLETION DATA:
(1) diameter (inches) 2"
(2) total depth (feet) 430'
(3) static water level (feet) 39' ^{below} / _{above} top of ground.
(4) casing GALV 420'
(material) (depth)
(size) If telescope see back.
(5) screen 10' 430'
(length) (depth to top)
2" 35'
(size) (material)
(6) pump 1 8
(HP) (yield gpm)
E
(type power)
(7) electric log _____
(yes or no)
(organization running log)
(8) how well bottom plugged _____
See above


description of formations encountered	from	to
TOP SOIL	0	20
SAND + GRAVEL	20	30
CLAY	30	305
COARSE GRAY SAND	305	310
BLUE CLAY	310	400
COARSE GRAY SAND	400	430

CODED

DRILLERS REMARKS:

If well telescopes please sketch and show depths.

GROUND LEVEL

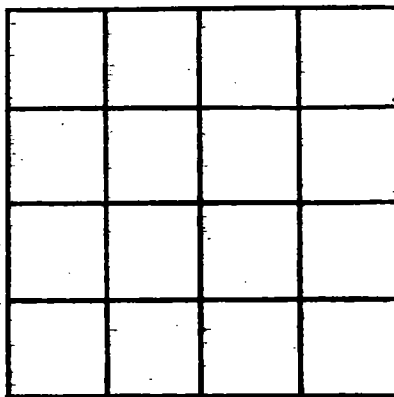

SECTION _____

Please indicate well location X.

ADDITIONAL INFORMATION

If more than one screen, show locations of each on sketch.