

JACKSON  
 J 131  
 3-22-74

MISSISSIPPI  
 BOARD OF WATER COMMISSIONERS CODED  
 416 North State Street  
 Jackson, Mississippi 39201

WATER WELL DRILLERS LOG

3-22 1974 *Switzer Well Co.* *Jackson*  
 date well completed firm name county well located

LANDOWNER	description of formations encountered	from	to
<i>Les Gabriel</i>	clay	0	15
<i>Shaman Rd</i>	sand	15	76
<i>Ocean Springs, Miss.</i>	clay	76	129
(mailing address)	sand	129	204
WELL LOCATION:	clay	204	232
sec <u>14</u> T. <u>6</u> S. R. <u>9</u> W.	sand	232	236
<u>4</u> miles <u>W</u> of <u>VENICE</u>	clay	236	285
(distance) (direction) (nearest town)	sand	285	288
WELL PURPOSE: <u>HOME</u>	clay	288	386
(home, irrigation, municipal, industrial)	sand	386	390
WELL COMPLETION DATA:	clay	390	407
(1) diameter (inches) <u>2</u>	fine sand	407	423
(2) total depth (feet) <u>460 ft.</u>	good sand	423	460
(3) static water level (feet) <u>62</u> <sup>(below)</sup> <sub>above</sub> top of ground.			
(4) casing <u>galv.</u> (material), <u>460'</u> (depth)			
<u>4</u> (size) if telescope see back.			
(5) screen <u>20</u> (length), <u>440'</u> (depth to top)			
<u>008</u> (size), <u>stainless steel</u> (material)			
(6) pump <u>1</u> (HP), (yield gpm)			
<u>elec.</u> (type power)			
(7) electric log <u>no</u> (yes or no)			
(organization running log)			
(8) how well bottom plugged <u>back</u>			
<u>Pressure values</u>			
DRILLERS REMARKS:			

CODED


RECORDED

APR 1 1974

MISS. BD. OF WATER COMM.

If well telescopes please sketch and show depths.

GROUND LEVEL

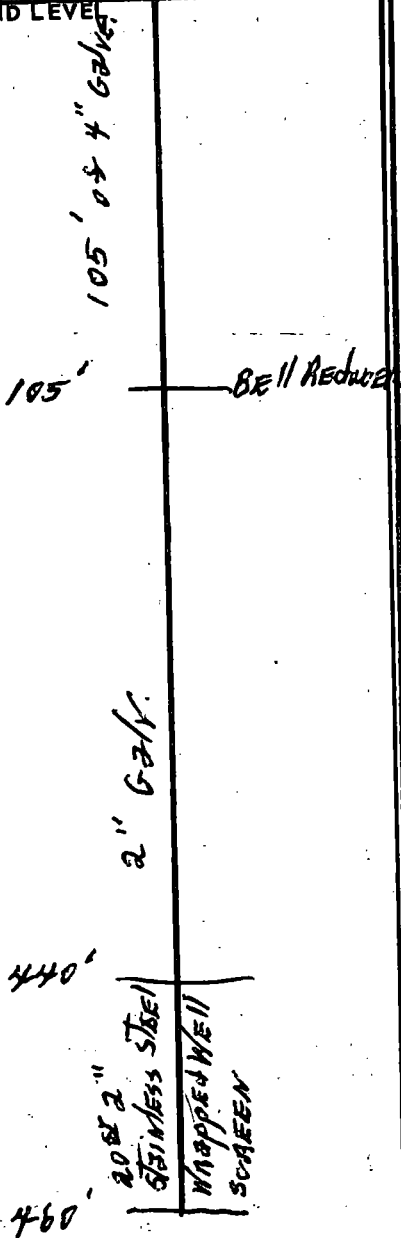

X			

SECTION 14

Please indicate well location X.

ADDITIONAL INFORMATION

If more than one screen, show locations of each on sketch.