


Jackson
J 133
9-26-74

MISSISSIPPI
 BOARD OF WATER COMMISSIONERS
 416 North State Street
 Jackson, Mississippi 39201
WATER WELL DRILLERS LOG

INDEXED


26 Sept 1974 GARLAND-WRIGHT WATER WELLS Jackson
 date well completed firm name county well located

LANDOWNER: <u>C. B. Fowler</u>	description of formations encountered	from	to
<u>Rt. 5, Box (Unknown)</u>	<u>Top Soil</u>	<u>1</u>	<u>4</u>
<u>Ocean Springs Miss</u> (mailing address) <u>39564</u>	<u>Sand</u>	<u>4</u>	<u>36</u>
WELL LOCATION:	<u>Grey Clay</u>	<u>36</u>	<u>167</u>
sec. <u>26</u> T. <u>6</u> S. R. <u>8</u> W.	<u>10/31 Sand</u>	<u>167</u>	<u>204</u>
<u>10</u> miles <u>NORTH</u> of <u>DEATH SPRING</u> (distance) (direction) (nearest town)			
WELL PURPOSE: <u>Home</u> (home, irrigation, municipal, industrial)			
WELL COMPLETION DATA:			
(1) diameter (inches) <u>2"</u>			
(2) total depth (feet) <u>202'</u>			
(3) static water level (feet) <u>40'</u> below above top of ground.			
(4) casing <u>Galvanized Pipe 1 1/2"</u> (material) (depth)			
<u>2"</u> (size) If telescope see back.			
(5) screen <u>10'</u> , <u>202'-192'</u> (length) (depth to top)			
<u>3"</u> , <u>Stainless Steel</u> (size) (material)			
(6) pump <u>1 HP</u> , <u>12</u> (HP) (yield gpm)			
<u>Electric</u> (type power)			
(7) electric log <u>No</u> (yes or no)			
(organization running log)			
(8) how well bottom plugged <u>Float</u>			
DRILLERS REMARKS:			

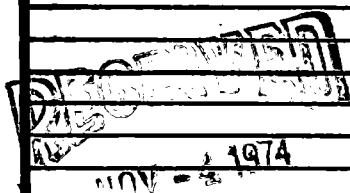

If well telescopes please sketch and show depths.

GROUND LEVEL

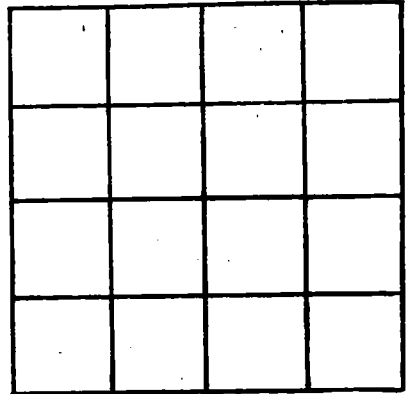

SECTION _____

Please indicate well location X.

ADDITIONAL INFORMATION

If more than one screen, show locations of each on sketch.