

Jackson
 J134
 3-7-75

MISSISSIPPI
 BOARD OF WATER COMMISSIONERS
 416 North State Street
 Jackson, Mississippi 39201

CODED

WATER WELL DRILLERS LOG

3/7 1975 date well completed
 COASTAL DRILLING & SERVICE CO.
 ROUTE 1 BOX 648 JACKSON county well located

LANDOWNER: Bill BILOXI, MISS 39537

description of formations encountered	from	to
Top Soil	1	3
White Sand	3	15
Soft Blue Clay	15	60
Red Sand	60	115
Soft Clay	115	210
Shale	210	215
Soft Clay	215	260
Chase water sand	260	270
hard Blue Clay	270	390
fine water sand	390	395
Coarse water sand	395	428

Moony
 Ocean Spring, Miss
 (mailing address)

WELL LOCATION:
 see 23 T 6 N R 9 E 135 S W
 (1) one miles S of Latimer
 (distance) (direction) (nearest town)

WELL PURPOSE: Home
 (home, irrigation, municipal, industrial)

WELL COMPLETION DATA:

- diameter (inches) 4 1/2"
- total depth (feet) 428'
- static water level (feet) 30 below above top of ground.
- casing PVC, 4 1/2" (material), (depth)
4 1/2" (size) If telescope see back.
- screen 15', 4 1/2" (length), (depth to top)
2", PVC (size), (material)
- pump One, 20 (HP) (yield gpm)
Ele (type power)
- electric log no (yes or no)

(organization running log)

(8) how well bottom plugged
2" pack wash down

DRILLERS REMARKS:

APPROVED
 JUN 17 1975

MISS. Bd. OF WATER COMM

If well telescopes please sketch and show depths.

GROUND LEVEL


160 ft 4" PVC
Casing

253' 2" PVC
Casing

15' 2" PVC Screen

2" backwash Jetter

If more than one screen,
show locations of each on sketch.

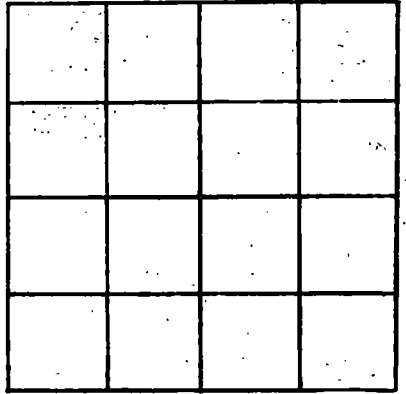

SECTION _____

Please indicate well location X.

ADDITIONAL INFORMATION

A series of horizontal lines provided for additional information.