

Jackson
J 136
9-13-74

MISSISSIPPI
 BOARD OF WATER COMMISSIONERS
 416 North State Street
 Jackson, Mississippi 39201

CODED

WATER WELL DRILLERS LOG

Sept. 13 1974 *McCall Well Works* Jackson
 date well completed firm name county well located


LANDOWNER:	description of formations encountered	from	to
<i>Claude E. Johnson</i>	<i>Clay</i>	<i>0</i>	<i>10</i>
<i>Rt 1 Box 1927</i>	<i>fine sand</i>	<i>17</i>	<i>41</i>
<i>Ocean Springs, Miss</i>	<i>blue clay</i>	<i>41</i>	<i>68</i>
WELL LOCATION:	<i>plush</i>	<i>68</i>	<i>94</i>
sec <i>10</i> T <i>6</i> N R <i>9</i> E	<i>fine sand</i>	<i>94</i>	<i>138</i>
<i>#1</i> miles <i>NW</i> of <i>Latimer</i>	<i>blue clay</i>	<i>138</i>	<i>197</i>
(distance) (direction) (nearest town)	<i>fine sand</i>	<i>197</i>	<i>234</i>
WELL PURPOSE: <i>Home</i>	<i>plush</i>	<i>234</i>	<i>283</i>
(home, irrigation, municipal, industrial)	<i>blue clay</i>	<i>283</i>	<i>336</i>
WELL COMPLETION DATA:	<i>plush</i>	<i>336</i>	<i>389</i>
(1) diameter (inches) <i>2"</i>	<i>fine sand</i>	<i>389</i>	<i>440</i>
(2) total depth (feet) <i>483</i>	<i>blue clay</i>	<i>440</i>	<i>461</i>
(3) static water level (feet), <i>32</i> <input checked="" type="checkbox"/> below <input type="checkbox"/> above top of ground	<i>coarse sand</i>	<i>461</i>	<i>483</i>
(4) casing <i>PVC</i> , <i>473</i>			
(material) (depth)			
<i>10'</i> If telescope see back.			
(size)			
(5) screen <i>10'</i> , <i>473</i>			
(length) (depth to top)			
<i>2"</i> , <i>SS</i>			
(size) (material)			
(6) pump <i>1</i> , <i>10</i>			
(HP) (yield gpm)			
<i>electric</i>			
(type power)			
(7) electric log <i>NO</i>			
(yes or no)			
(organization running log)			
(8) how well bottom plugged <i>sand & shell</i>			
<i>back wash with</i>			
DRILLERS REMARKS:			

RECEIVED
 JAN 21 1975

JAN 21 1975

If well telescopes please sketch and show depths.

GROUND LEVEL

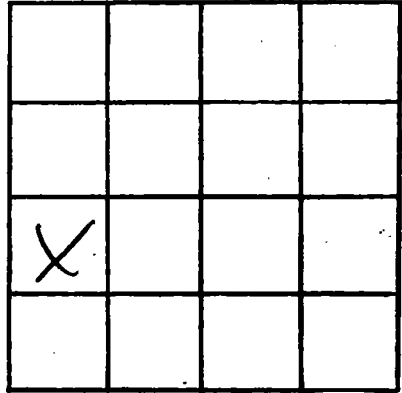

SECTION 10

Please indicate well location X.

ADDITIONAL INFORMATION

If more than one screen, show locations of each on sketch.