

JACKSON
J 138
6-20-74

MISSISSIPPI
 BOARD OF WATER COMMISSIONERS
 416 North State Street
 Jackson, Mississippi 39201

CODED

WATER WELL DRILLERS LOG

6/20 1974 date well completed
 COAST WATER WELL SERVICE firm name
 Jackson county well located

LANDOWNER: Hill House

Lot 2 - P.O. Box 854

Ocean Springs, Mo.
 (mailing address)

description of formations encountered	from	to
top soil	0	8
blue clay	8	39
coarse sand	39	121
blue clay	121	124
coarse sand	124	129
blue clay	129	148
coarse sand	148	180

WELL LOCATION:

sec. 29 T 6 N R 8 E
 S
 4 1/2 miles N.E. of Ocean Springs
 (distance) (direction) (nearest town)

WELL PURPOSE: home
 (home, irrigation, municipal, industrial)


WELL COMPLETION DATA:

- (1) diameter (inches) 2"
- (2) total depth (feet) 180'
- (3) static water level (feet) 6 below top of ground
- (4) casing PVC 170'
 (material) (depth)
2"
 (size) if telescope see back.
- (5) screen 10' 170'
 (length) (depth to top)
2" PVC
 (size) (material)
- (6) pump 1/2 7
 (HP) (yield gpm)
elec.
 (type power)
- (7) electric log NO
 (yes or no)

(organization running log)

(8) how well bottom plugged value


DRILLERS REMARKS:

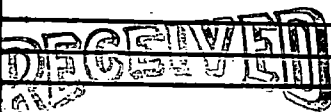

MAY 16 1975

If well telescopes please sketch and show depths.

GROUND LEVEL

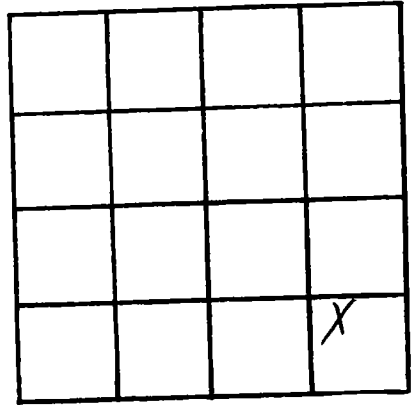

SECTION 29

Please indicate well location X.

ADDITIONAL INFORMATION

If more than one screen,
show locations of each on sketch.