

Jackson
 J 143
 8-14-75

MISSISSIPPI
 BOARD OF WATER COMMISSIONERS
 416 North State Street
 Jackson, Mississippi 39201

CODED

WATER WELL DRILLERS LOG

14 Aug 1975 BOBENT WELL CO JACKSON
 date well completed firm name county well located

LANDOWNER: Loyd HARRISON
RT 2 BOX 365
OCEAN SPRINGS, MS. 39564
 (mailing address)

description of formations encountered	from	to
Red clay w/sand str.	0	66
Red sand	66	76
Blue clay	76	130
Good sand (BUST?)	130	200
Blue clay	200	327
Good sand	327	390

WELL LOCATION:
 sec 23 T 6 S R 6 W ¹³⁵
4 miles W of YANDELE
 (distance) (direction) (nearest town)

WELL PURPOSE:
 home irrigation, municipal, industrial

WELL COMPLETION DATA:

(1) diameter (inches) 2

(2) total depth (feet) 390

(3) static water level (feet) 57 below above top of ground.

(4) casing PVC, 3 (material) (depth)
 (size) if telescope see back.

(5) screen 10, 380 (length) (depth to top)
10, PVC (size) (material)

(6) pump 1, 10 (HP) (yield gpm)
ELECT (type power)

(7) electric log No (yes or no)
 (organization running log)

(8) how well bottom plugged sand
SPARK


CODED

DRILLERS REMARKS:

SEP - 8 1975

If well telescopes please sketch and show depths.

GROUND LEVEL

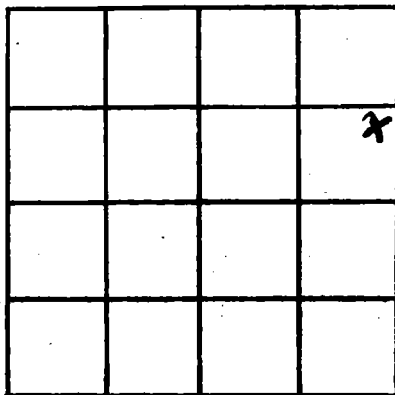

SECTION 23

Please indicate well location X.

ADDITIONAL INFORMATION

If more than one screen, show locations of each on sketch.