

Jackson
 J 146
 4-19-74

MISSISSIPPI
 BOARD OF WATER COMMISSIONERS
 416 North State Street
 Jackson, Mississippi 39201

CODED

WATER WELL DRILLERS LOG
 COASTAL DRILLING & SERVICE CO.

Jackson
 county well located

9/19 1974 date well completed
 ROUTE 1 BOX 618 firm name
 BILOXI, MISS. 39532

LANDOWNER: Green past
 Pt 2 B of 325 BK.
 Ocean Springs Miss
 (mailing address)

description of formations encountered	from	to
Top Soil	3	3
Red Sand	3	18
White Sand	18	40
Soft Blue Clay	40	200
Hard Blue Clay	500	330
Coarse Water Sand	230	240
Hard Blue Clay	240	400
Fine Water Sand	400	440
Coarse Water Sand	440	483

WELL LOCATION:
 sec. 15 T. 4 N. R. 8 E. 13 S
 S W
 1/2 (16) miles NE Zaturer
 (distance) (direction) (nearest town)

WELL PURPOSE: Home
 (home, irrigation, municipal, industrial)


WELL COMPLETION DATA:

- (1) diameter (inches) 2"
- (2) total depth (feet) 483
- (3) static water level (feet) 400 below above top of ground.
- (4) casing steel 473' (material) (depth)
- (size) if telescope see back.
- (5) screen 10' 473' (length) (depth to top)
 2" (size) (material)
- (6) pump (HP) (yield gpm)
 Ele (type power)
- (7) electric log no (yes or no)

(organization running log)

(8) how well bottom plugged
 2" lead with water

DRILLERS REMARKS:

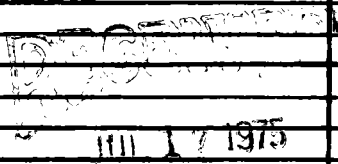

If well telescopes please sketch and show depths.

GROUND LEVEL

SECTION _____

Please indicate well location X.

ADDITIONAL INFORMATION

If more than one screen, show locations of each on sketch.