

Jackson  
 J 147  
 5-27-75

MISSISSIPPI  
 BOARD OF WATER COMMISSIONERS  
 416 North State Street  
 Jackson, Mississippi 39201

CODED

WATER WELL DRILLERS LOG

COASTAL DRILLING & SERVICE CO. *Jackson*

ROUTE # *1* BOX *618*

date well completed *5/27/75*

county well located *Jackson*

LANDOWNER *R. D. Dune* BILOXI, MISS. 39532  
 (DOWN IN)

DESCRIPTION OF FORMATIONS encountered	from	to
<i>top soil</i>	<i>1</i>	<i>3</i>
<i>white sand</i>	<i>3</i>	<i>10</i>
<i>red clay sand</i>	<i>40</i>	<i>25</i>
<i>soft shales</i>	<i>25</i>	<i>240</i>
<i>fine water sand</i>	<i>240</i>	<i>270</i>
<i>hard blue clay</i>	<i>270</i>	<i>460</i>
<i>fine water sand</i>	<i>460</i>	<i>480</i>
<i>coarse water sand</i>	<i>480</i>	<i>525</i>

*429 Woody Ave*  
*Ocean Springs, Miss*  
 (mailing address)

WELL LOCATION:  
 sec *10* T *6* N R *8* E  
 S W  
*16 1/2* miles W *Vandeventer* of *135*  
 (distance) (direction) (nearest town)


WELL PURPOSE: *Camp*  
 (home, irrigation, municipal, industrial)

WELL COMPLETION DATA:

- (1) diameter (inches) *2"*
  - (2) total depth (feet) *525'*
  - (3) static water level (feet) *60* below top of ground.
  - (4) casing *P.C. 495'*  
 (material) (depth)
  - (5) screen *10'* *495'*  
 (length) (depth to top)  
*2"* *P.C.*  
 (size) (material)
  - (6) pump *one* *9gal*  
 (HP) (yield gpm)  
*Ele*  
 (type power)
  - (7) electric log *no*  
 (yes or no)
- (organization running log)

(8) how well bottom plugged  
*2 1/2 inch well*


DRILLERS REMARKS:

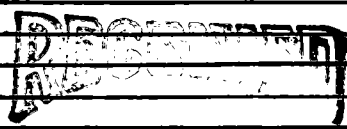

JUL 17 1975

If well telescopes please sketch and show depths.

GROUND LEVEL

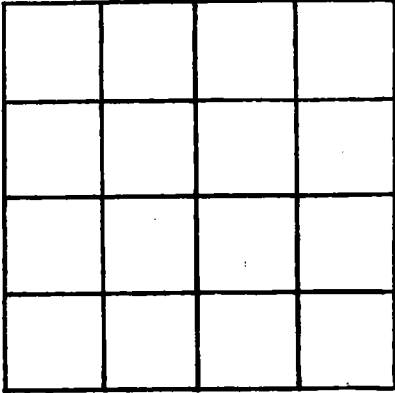

SECTION \_\_\_\_\_

Please indicate well location X.

ADDITIONAL INFORMATION

A series of horizontal lines for writing additional information.

If more than one screen, show locations of each on sketch.